


Give All Information Completely
Make Required Affidavit
Mail or Deliver Report to:
Conservation Division
State Corporation Commission
211 No. Broadway
Wichita, Kansas

WELL PLUGGING RECORD

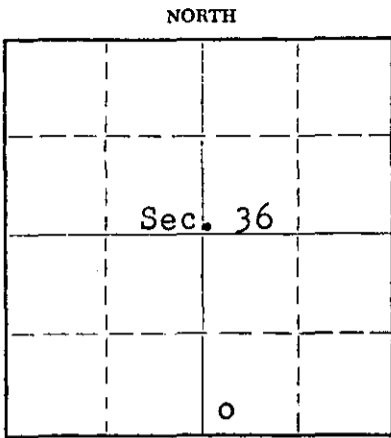

Locate well correctly on above Section Plat

Barber County. Sec. 36 Twp. 31 Rge. 10 (E) (W) (W)
Location as "NE/CNWxSWx" or footage from lines SW SW SE
Lease Owner PETROLEUM INC.
Lease Name BEST "D" Well No. 1
Office Address Route 2, Great Bend, Kansas
Character of Well (completed as Oil, Gas or Dry Hole) Dry Hole
Date well completed January 18 19 57
Application for plugging filed January 18 19 57
Application for plugging approved January 18 19 57
Plugging commenced January 18 19 57
Plugging completed January 18 19 57
Reason for abandonment of well or producing formation No Produccible Zones

If a producing well is abandoned, date of last production None 19
Was permission obtained from the Conservation Division or its agents before plugging was commenced? Yes

Name of Conservation Agent who supervised plugging of this well M.A. Rives, Box 8, Pratt, Kansas
Producing formation ---- Depth to top ---- Bottom ---- Total Depth of Well 4500 Feet
Show depth and thickness of all water, oil and gas formations.

OIL, GAS OR WATER RECORDS

CASING RECORD

FORMATION	CONTENT	FROM	TO	SIZE	PUT IN	PULLED OUT
				8 5/8" OD	205'	None

Describe in detail the manner in which the well was plugged, indicating where the mud fluid was placed and the method or methods used in introducing it into the hole. If cement or other plugs were used, state the character of same and depth placed, from _____ feet to _____ feet for each plug set.

Mud up with heavy mud to 200', pushed down 1/4 sack hulls to 200' followed by wooden plug. Placed 20 sacks cement through drill on to plug. Mud up to 35' and place 1/4 sack hulls at 35' followed by wooden plug and 10 sacks cement to base of well cellar.

(If additional description is necessary, use BACK of this sheet)
Name of Plugging Contractor Garvey Drilling Company
Address Route 2, Great Bend, Kansas

STATE OF KANSAS, COUNTY OF BARTON, ss.
DON SEARLE (employee of owner) or (~~owner or operator~~) of the above-described well, being first duly sworn on oath, says: That I have knowledge of the facts, statements, and matters herein contained and the log of the above-described well as filed and that the same are true and correct. So help me God.
(Signature) Don Searle
Route 2, Great Bend, Kansas (Address)

SUBSCRIBED AND SWORN TO before me this 22nd day of January, 19 57
Ed J. Brown Notary Public.

My commission expires July 11, 1960

PLUGGING
FILE SEC 36 T. 31 R. 10W
BOOK PAGE 125 LINE 21

RECEIVED
STATE CORPORATION COMMISSION
JAN 23 1957
CONSERVATION DIVISION
Wichita, Kansas
1-23-57

WELL LOG

COMPANY **PETROLEUM, INCORPORATED**

SEC. 36 T. 31S R. 10W

FARM **BEST 'D'** NO. 1


LOC. SW,SW,SE

TOTAL DEPTH **4500'**

COUNTY **Barber Co., Kansas**

COMM. **January 2, 1957** COMP. **January 18, 1957**

CONTRACTOR **GARVEY DRILLING COMPANY**

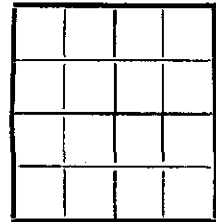

CASING **8 5/8" @ 205' W/125 sax.**

ELEVATION **1577' DF**

PRODUCTION **D & A**

FIGURES INDICATE BOTTOM OF FORMATIONS

205	Sand, clay & Red bed.	Anhydrite	1237'
925	Red bed & shale	Heebner	3551
1237	Shale	Douglas	3627
1250	Anhydrite	Lansing	3718
1426	Shale		
1570	Lime & shale		
1820	Lime		
1870	Lime & shale		
2205	Lime		
3444	Lime & shale		
3525	Lime		
3694	Lime & shale		
3718	Sand, lime & shale		
4500	Lime.		
4500	T. D.		

State of KANSAS }
 County of BARTON } ss:

I, Verne A. Morris of Garvey Drilling Company

upon oath state that the above and foregoing is a true and correct copy of the log of the #1 Best 'D' well

FILE SEC 36 T. 31 R. 10W
 BOOK PAGE 135 LINE 21

RECEIVED
 STATE CORPORATION COMMISSION
Verne A. Morris

Subscribed and sworn to before me this 21st day of January 1957 19 57

My Commission Expires: July 11, 1960

CONSERVATION DIVISION
 WICHITA, KANSAS NOTARY PUBLIC
W. B. Brown