


WELL PLUGGING RECORD

Give All Information Completely
Make Required Affidavit
Mail or Deliver Report to:
Conservation Division
State Corporation Commission
211 No. Broadway
Wichita, Kansas

Barber County, Sec. 13 Twp. 32S Rge. (E) 11 (W)

NORTH

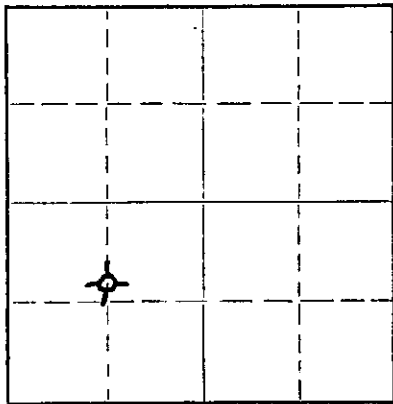

Locate well correctly on above Section Plat

Location as "NE/CNWxSWx" or footage from lines _____
Lease Owner Champlin Oil & Refining Co.
Lease Name Joe A. Hrencher Well No. 1
Office Address 306 Koch Building, Wichita, Kansas
Character of Well (completed as Oil, Gas or Dry Hole) Dry Hole
Date well completed March 18 19 57
Application for plugging filed March 18 19 57
Application for plugging approved March 18 (Verbal) 19 57
Plugging commenced March 18 19 57
Plugging completed March 18 19 57
Reason for abandonment of well or producing formation _____

If a producing well is abandoned, date of last production _____ 19 ____
Was permission obtained from the Conservation Division or its agents before plugging was commenced? Yes

Name of Conservation Agent who supervised plugging of this well M. A. Rives
Producing formation _____ Depth to top _____ Bottom _____ Total Depth of Well 4508 Feet
Show depth and thickness of all water, oil and gas formations.

OIL, GAS OR WATER RECORDS

CASING RECORD

FORMATION	CONTENT	FROM	TO	SIZE	PUT IN	PULLED OUT
				10-3/4" O.D.	B. 235'	NONE

Describe in detail the manner in which the well was plugged, indicating where the mud fluid was placed and the method or methods used in introducing it into the hole. If cement or other plugs were used, state the character of same and depth placed, from _____ feet to _____ feet for each plug set.

Filled hole with heavy mud from 4508' to 225', Pushed 1/3 sack of hulls and wooden plug to 225' and pumped in 20 sacks of cement thru drill pipe then filled hole with heavy mud from top of cement to 35' and pushed wooden plug to 35' w/ 1/4 sack of hulls on top of plug and used 10 sacks of cement to fill hole to bottom of cellar.

(If additional description is necessary, use BACK of this sheet)

Name of Plugging Contractor Gabbert & Jones Drilling Company
Address Wichita, Kansas

STATE OF Kansas, COUNTY OF Sedgwick, ss.
J. W. Meyers (employee of owner) or (owner or operator) of the above-described well, being first duly sworn on oath, says: That I have knowledge of the facts, statements, and matters herein contained and the log of the above-described well as filed and that the same are true and correct. So help me God.

(Signature) [Signature]
Room 306 Koch Bldg.
Wichita, Kansas (Address)

SUBSCRIBED AND SWORN to before me this 1st day of April, 1957
[Signature]
Notary Public.

My commission expires 2-22-61

PLUGGING
FILE SEC 13 T. 32 R. 11W
BOOK PAGE 149 LINE 4

RECEIVED
STATE CORPORATION COMMISSION
APR 3 - 1957
4-3-57
CONSERVATION DIVISION
Wichita, Kansas

GABBERT-JONES DRILLING CO., INC.
WICHITA, KANSAS
DRILLER'S WELL LOG

Joe A. Hrencher #1
 Se Sw SW Section 13-32-11W
 Barber County, Kansas
 Commenced 2-28-57
 Completed 3-19-57

Depth		Formation	Remarks
From	To		
0	40	Surface Clay & Sand	Ran 235' of 10-3/4" Casing Cemented w/250 sacks cement
40	250	Red bed & shells	
250	685	Red Bed	
685	1280	Shale & Shells	
1280	1305	Shale	
1305	1385	Anmydrite	
1385	1830	Shale & Lime	
1830	1945	Lime	
1945	2175	Lime & Shale	
2175	2260	Lime	
2260	2465	Shale & Shella	
2465	3105	Shale & Lime	
3105	3170	Lime	
3170	3585	Lime & Shale	
3585	3625	Lime & Sand	
3625	3638	Lime & Shale	
3638	3790	Sand, Shale & Lime	
3790	4508	Lime	
4508	TD		Dry & Abandoned

I, J. W. Meyers, certify this to be a true and correct copy of the Driller's Well Log for the Joe A. Hrencher #1.

J. W. Meyers

RECEIVED
 STATE CORPORATION COMMISSION

APR 3 - 1957
 4-3-57

CONSERVATION DIVISION

STATE OF KANSAS)
 COUNTY OF SEDGWICK)

Before me, the undersigned, a Notary Public, within and for said county and State, on this 1st day of April, 1957, personally appeared J. W. Meyers to me personally known to be the identical person who executed the within and foregoing instrument and acknowledged to me that he executed the same as his free and voluntary act and deed for the uses and purposes therein set forth.

IN WITNESS WHEREOF, I have hereunto set my hand and official seal the day and year last above written.

My commission expires 2-22-61

[Signature]
 NOTARY PUBLIC

PLUGGING
 FILE SEC 13 T. 32 R. 11w
 BOOK PAGE 149 LIT E 4