

15-007-01002-0000


STATE OF KANSAS
STATE CORPORATION COMMISSION

Give All Information Completely
Make Required Affidavit
Mail or Deliver Report to:
Conservation Division
State Corporation Commission
211 No. Broadway
Wichita, Kansas

WELL PLUGGING RECORD

Barber County, Sec. 13 Twp. 32S Rge. (X) 11 (W)

Location as "NE/CNW/SW" or footage from lines C SW NE
Lease Owner Gulf Oil Corporation
Lease Name G. McGuire Well No. 1
Office Address Box 661, Tulsa, Oklahoma
Character of Well (completed as Oil, Gas or Dry Hole) Dry Hole
Date well completed 7-21 19 57
Application for plugging filed (Verbally) 7-21 19 57
Application for plugging approved (Verbally) 7-21 19 57
Plugging commenced 7-21 19 57
Plugging completed 7-21 19 57
Reason for abandonment of well or producing formation Dry Hole

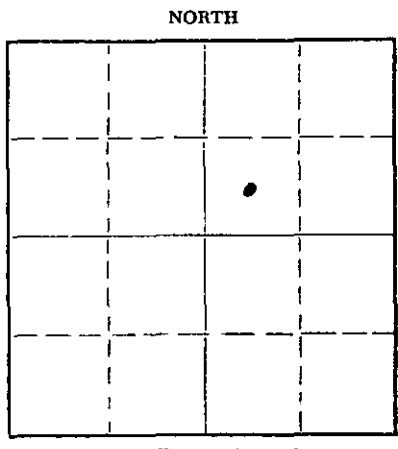

Locate well correctly on above Section Plat

If a producing well is abandoned, date of last production 19
Was permission obtained from the Conservation Division or its agents before plugging was commenced? yes

Name of Conservation Agent who supervised plugging of this well M. A. Rives
Producing formation _____ Depth to top _____ Bottom _____ Total Depth of Well 4573 Feet
Show depth and thickness of all water, oil and gas formations.

OIL, GAS OR WATER RECORDS

CASING RECORD

FORMATION	CONTENT	FROM	TO	SIZE	PUT IN	PULLED OUT
				8-5/8"	293	-0-

Describe in detail the manner in which the well was plugged, indicating where the mud fluid was placed and the method or methods used in introducing it into the hole. If cement or other plugs were used, state the character of same and depth placed, from _____ feet to _____ feet for each plug set.

Filled with mud to 275', Spotted 20 sx. cement. Filled with mud to 35'.
Dumped 1/2 sx. cotton seed hulls and capped with 15 sx. cement filling hole to base of collar.

NOTE: Attached is Driller's Formation Record which was not available at time application was submitted.

(If additional description is necessary, use BACK of this sheet)

Name of Plugging Contractor Barbour Drilling Company
Address First Nat'l Bank Bldg., Tulsa, Oklahoma

STATE OF Kansas, COUNTY OF Sedgwick, ss.
Thomas A. Trax (employee of owner) of the above-described well, being first duly sworn on oath, says: That I have knowledge of the facts, statements, and matters herein contained and the log of the above-described well as filed and that the same are true and correct. So help me God.

(Signature) [Signature]
THOMAS A. TRAX, Area Supt. of Production
Box 2233, Wichita, Kansas

SUBSCRIBED AND SWORN TO before me this 23rd day of July, 19 57

My commission expires 2-4-59

RAY W. ROUSER, Notary Public.
STATE CORPORATION COMMISSION

JRM:RAW

PLUGGING
FILE SEC 13 T 32 R 11W
BOOK PAGE 29 LINE 25

JUL 31 1957
7-31-57
CONSERVATION DIVISION
Wichita, Kansas

15-007-01002-0000

GEORGE MCGUIDRE NO. 1

SW NE Section 13-32S-11W
Barber County, Kansas
Gulf Oil Corporation

8-5/8" O. D. casing cemented at 292'

Drilling commenced 7-7-57
Drilling completed 7-21-57

FROM	TO	FORMATION	REMARKS
0'	45'	Sand & rock	
45	650	led bed & shells	
650	1075	shale & shells	8-5/8" O. D. casing set with 250 sacks common cement at 292'
1075	1770	Anhydrite & shale	
1770	1805	Lime & shale	
1805	1865	shale & lime	
1865	2425	lime & shale	
2425	2880	shale	
2880	2900	shale & shells	
2900	3005	shale & lime	
3025	3370	lime & shale	
3370	3250	shale & lime	
3250	3570	lime & shale	
3570	3650	sandy lime & shale	
3650	3695	lime & shale	
3695	3795	shale & sand	
3795	3840	shale & lime	
3820	3915	lime & shale	
3915	4355	lime	
4355	4395	lime with shale streaks	
4398	4573	lime	Well plugged
T. D.	4573'		

RECEIVED
STATE CORPORATION COMMISSION

JUL 31 1957
7-31-57
CONSERVATION DIVISION
Wichita, Kansas

PLUGGING
FILE SEC. 19 T. 32 R. 11W
BOOK PAGE 24 LINE 25