


STATE OF KANSAS
STATE CORPORATION COMMISSION

Give All Information Completely
Make Required Affidavit
Mail or Deliver Report to:
Conservation Division
State Corporation Commission
211 No. Broadway
Wichita, Kansas

WELL PLUGGING RECORD

NORTH

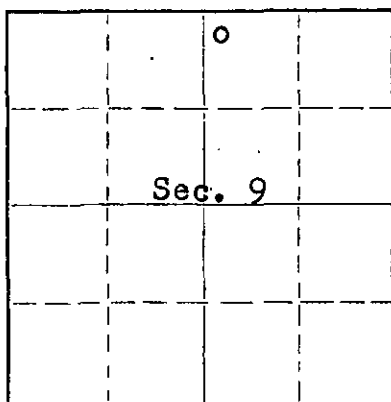

Locate well correctly on above
Section Plat

Barber

County. Sec. 9 Twp. 32 Rge. 11 (E) W (W)

Location as "NE/CNW&SW&" or footage from lines NW NW NE

Lease Owner Petroleum, Inc.

Lease Name Cox "D"

Well No. 1

Office Address Route 2, Great Bend, Kansas

Character of Well (completed as Oil, Gas or Dry Hole) Dry hole

Date well completed May 23 1958

Application for plugging filed May 23 1958

Application for plugging approved May 23 1958

Plugging commenced May 23 1958

Plugging completed May 23 1958

Reason for abandonment of well or producing formation No producible zones

If a producing well is abandoned, date of last production none 19

Was permission obtained from the Conservation Division or its agents before plugging was commenced? yes

Name of Conservation Agent who supervised plugging of this well W. L. Lackamp, Stafford, Kansas

Producing formation ----- Depth to top --- Bottom --- Total Depth of Well 4441 Feet

Show depth and thickness of all water, oil and gas formations.

OIL, GAS OR WATER RECORDS

CASING RECORD

FORMATION	CONTENT	FROM	TO	SIZE	PUT IN	PULLED OUT
				8 5/8"	252'	None

Describe in detail the manner in which the well was plugged, indicating where the mud fluid was placed and the method or methods used in introducing it into the hole. If cement or other plugs were used, state the character of same and depth placed, from _____ feet to _____ feet for each plug set.

Mud up with heavy mud to 250' followed by wooden plug. Placed 20 sacks cement through drill pipe on to plug. Mud up to 40' and placed 1/2 sack hulls at 40' followed by wooden plug and 10 sacks cement to base of well cellar.

RECEIVED
STATE CORPORATION COMMISSION

JUN 5 1958
6-3-58
CONSERVATION DIVISION
Wichita, Kansas

(If additional description is necessary, use BACK of this sheet)

Name of Plugging Contractor Garvey Drilling Company

Address Route 2, Great Bend, Kansas

STATE OF Kansas, COUNTY OF Barton, ss.

Don Searle

(employee of owner) or (owner of property) of the above-described

well, being first duly sworn on oath, says: That I have knowledge of the facts, statements, and matters herein contained and the log of the above-described well as filed and that the same are true and correct. So help me God.

(Signature)

Route 2, Great Bend, Kansas

(Address)

SUBSCRIBED AND SWORN TO before me this 2nd day of June 1958

My commission expires July 11, 1960

Notary Public.

PLUGGING

FILE SEC 9 T 32 R 11W

BOOK PAGE 103 LINE 2

15-007-00593-0000
WELL LOG

COMPANY PETROLEUM INCORPORATED

SEC. 9 T. 32 R. 11

FARM COX

NO. D-1

LOC. NW NW NE

TOTAL DEPTH 4441'


COUNTY BARBER CO., KANS.

COMM. 5-9-58

COMP. 5-23-58

CONTRACTOR GARVEY DRILLING COMPANY

CASING 8-5/8" @ 252 W/175 sax

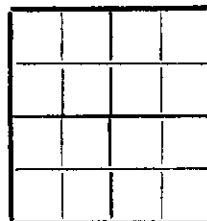

ELEVATION 1523 D.F.

PRODUCTION D & A

FIGURES INDICATE BOTTOM OF FORMATIONS

40	Surface Clay & Sand Rock
80	Red Bed & Sand Streaks
195	Red Bed & Gypsum
252	Red Bed
430	Red Bed Shells
750	Red Bed
1550	Shale & Shells
1640	Shale & Lime
1720	Lime
1855	Lime & Shale
2200	Shale & Lime
2353	Shale
2540	Shale & Shells
3035	Shale
3404	Shale & Lime
3570	Shale
3650	Shale & Lime & Sand
3735	Shale
4192	Lime
4324	Shale & Lime
4355	Shale & Chert
4375	Lime & Chert
4434	Chert
4441	Lime

RECEIVED
STATE CORPORATION COMMISSION

JUN 3 1958
6-3-58
CONSERVATION DIVISION
Wichita, Kansas

PLUGGING

FILE SEC. 9 T. 32 R. 11 W
BOOK PAGE 103 LINE 2

State of KANSAS

County of BARTON

ss:

I, L. J. WEBER of GARVEY DRILLING COMPANY

upon oath state that the above and foregoing is a true and correct copy of the log of the #1 COX D well

Subscribed and sworn to before me this 29th day of May, 1958

My Commission Expires: July 11, 1960

L. J. Weber

Ed T. Brown
NOTARY PUBLIC