


WELL PLUGGING RECORD

Give All Information Completely
Make Required Affidavit
Mail or Deliver Report to:
Conservation Division
State Corporation Commission
211 No. Broadway
Wichita, Kansas

NORTH

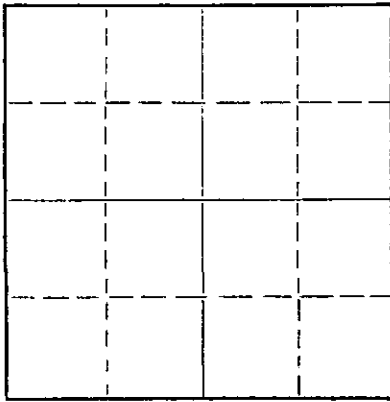

Locate well correctly on above
Section Plat

Barber County, Sec. 35 Twp. 30S Rge. 13 (X) (W)

Location as "NE/CNW&SW" or footage from lines SE SE SW

Lease Owner Sierra Petroleum Co., Inc. Musgrove Petroleum Corporation

Lease Name Hartley #1 Well No. #1

Office Address 420 West Douglas 518 Petroleum Bldg., Wichita, Kansas

Character of Well (completed as Oil, Gas or Dry Hole) Dry

Date well completed 7/18/56 19

Application for plugging filed 7/17/56 19

Application for plugging approved 7/17/56 19

Plugging commenced 7/18/56 19

Plugging completed 7/18/56 19

Reason for abandonment of well or producing formation Dry

If a producing well is abandoned, date of last production _____ 19

Was permission obtained from the Conservation Division or its agents before plugging was commenced? Yes

Name of Conservation Agent who supervised plugging of this well Mr. Rives

Producing formation _____ Depth to top _____ Bottom _____ Total Depth of Well 4761 Feet

Show depth and thickness of all water, oil and gas formations.

OIL, GAS OR WATER RECORDS

CASING RECORD

FORMATION	CONTENT	FROM	TO	SIZE	PUT IN	PULLED OUT
				8 5/8"	384'	None

Describe in detail the manner in which the well was plugged, indicating where the mud fluid was placed and the method or methods used in introducing it into the hole. If cement or other plugs were used, state the character of same and depth placed, from _____ feet to _____ feet for each plug set.

PLUGGING REPORT

Filled hole with heavy mud from 4761 to 300'. From 300' to 260' with hulls, wood plug and 20 sacks cement through drill pipe. Filled from 260' to 35' with heavy mud. From 35' to cellar - 0', filled with hulls, wood plug, and 10 sacks cement. Job completed 5:30 AM 7-18-56.

W.F.D.
CORPORATION COMMISSION
JUL 27 1956 7:27:56
CONSERVATION DIVISION
Wichita, Kansas

(If additional description is necessary, use BACK of this sheet)

Name of Plugging Contractor Sierra Petroleum Company, Inc.
Address 420 West Douglas Ave., Wichita, Kansas

STATE OF KANSAS, COUNTY OF RUSSELL, ss.
C. T. Honaker (employee of owner) or (owner or operator) of the above-described well, being first duly sworn on oath, says: That I have knowledge of the facts, statements, and matters herein contained and the log of the above-described well as filed and that the same are true and correct. So help me God.

(Signature) C. T. Honaker

Great Bend, Kansas
(Address)

SUBSCRIBED AND SWORN TO before me this 24th day of July, 1956

My commission expires 10-17-56

Leroy Dietz
Notary Public.

PLUGGING
FILE SEC 35 T. 30 R. 13 W
BOOK PAGE 84 LI. E. 18

Sierra Petroleum Co., Inc.
HARTLEY #1

SE SE SW 35-30S-13W
Barber County, Kansas

Total Depth: 4761*

Elev: 1777 GL

Comm: 6/27/56
Comp: 7/18/56

Casing	Cement
8 5/8" @ 384*	250 sacks Bulk

FORMATION	DEPTH
Shale & sand	50
Redbed & shale	840
Shale & Anhydrite	1160
Shale & shells	1465
Shale & lime	3815
Shale & sand	3839
Sand	3854
Lime & shale	3908
Lime	4020
Lime & shale	4095
Lime	4355
Lime & chert	4393
Lime	4439
Lime & shale	4515
Lime	4567
Sand & shale	4694
Lime	4761
TOPS: Anhydrite	854

STATE OF KANSAS)
) ss:
COUNTY OF RUSSELL)

I hereby certify that the above information is true and correct to the best of my knowledge.

C. P. Honaker

Subscribed to and sworn to before me this 24th day of July, 1956

Leroy L. Dreyer
Notary Public

My commission expires: 10-17-59

RECEIVED
STATE CORPORATION COMMISSION

JUL 27 1956

CONCERNING THE STATE OF KANSAS
CORPORATION COMMISSION

PLUGGING
FILE SEC 35 T 30 R 13W
BOOK PAGE 84 LINE 18