

STATE OF KANSAS
STATE CORPORATION COMMISSION

WELL PLUGGING RECORD

Give All Information Completely
Make Required Affidavit
Mail or Deliver Report to:
Conservation Division
State Corporation Commission
800 Bittling Building
Wichita, Kansas

OR
FORMATION PLUGGING RECORD

Strike out upper line
when reporting plug-
ging off formations.

Barber County. Sec. 32 Twp. 30 Rge. 13 (E) W (W)

Location as "NE 1/4 NW 1/4 SW 1/4" or footage from lines NW SE NE

Lease Owner J. M. Huber Corp.

Lease Name Gant #B-1 Well No.

Office Address Box 460 - Pratt, Kansas

Character of Well (completed as Oil, Gas or Dry Hole) 011

Date well completed 12-22-45 19.

Application for plugging filed 5-27-50 19.

Application for plugging approved 5-28-50 19.

Plugging commenced 5-28-50 19.


Plugging completed 6-5-50 19.

Reason for abandonment of well or producing formation

Production Exhausted

If a producing well is abandoned, date of last production 19.

Was permission obtained from the Conservation Division or its agents before plugging was commenced? Yes

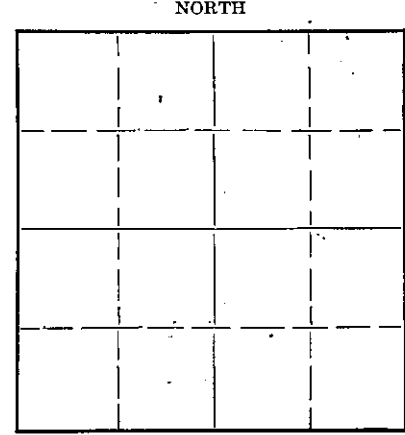

Locate well correctly on above
Section Plat

Name of Conservation Agent who supervised plugging of this well C. D. Stough - Great Bend, Kansas

Producing formation Depth to top Bottom Total Depth of Well 4569 Feet

Show depth and thickness of all water, oil and gas formations.

OIL, GAS OR WATER RECORDS

CASING RECORD

Formation	Content	From	To	Size	Put In	Pulled Out
				10 3/4"	805'	None
				5 1/2"	4558'	2997'

Describe in detail the manner in which the well was plugged, indicating where the mud fluid was placed and the method or methods used in introducing it into the hole. If cement or other plugs were used, state the character of same and depth placed, from.....feet to.....feet for each plug set.

Set fresh water plug at 250' and cemented w/20 sacks. Mudded hole to 30' and cemented w/ 10 sacks.

(If additional description is necessary, use BACK of this sheet)

Correspondence regarding this well should be addressed to W. W. Henson
Address Box 460
Pratt, Kansas

STATE OF KANSAS COUNTY OF PRATT
I. J. L. Kyler (employee of owner) or (owner or operator) of the above described well,
being first duly sworn on oath, says: That I have knowledge of the facts, statements, and matters herein contained and the log of the above-described well as filed and that the same are true and correct. So help me God.

(Signature) JUL 11 1950

SUBSCRIBED AND SWORN to before me this 9th day of July


STATE CORPORATION COMMISSION
KANSAS 50

My commission expires August 20, 1950

Notary Public.

22-2626

2-48-15M

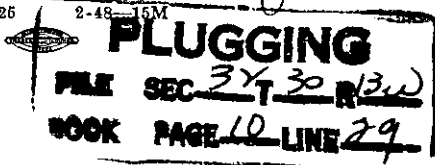

DRIILLERS LOG

GANT #B-1
 NW SE NE
 Sec. 32-30S-13W
 Barber County, Kansas

COMMENCED: 8-12-45
 COMPLETED: 12-22-45

CASING RECORD:

10 3/4" Set at 805' w/300 sacks
 5 1/2" Set at 4558' w/225 sacks

Production 1 BO/hr.
 852 MCF Gas

RB-shale, shells	0	775
Anhydrite	775	795
Shale	795	800
Shale, shells	800	805
RB, shale, shells	805	875
Shale, shells	875	1400
Salt, Shells	1400	1545
Salt, shale, shells	1545	1730
Shale, Lime, shells	1730	1870
Lime, shale	1870	2050
Lime	2050	2125
Lime, shale	2125	2221
Sandy lime	2221	2340
Lime, shale	2340	2552
Lime	2552	2590
Lime, shale	2590	2775
Shale, shells	2775	3080
Lime, shale	3080	3290
Lime	3290	3385
Lime, shale	3385	3705
Lime	3705	3845
Shale	3845	3920
Sand, Shale	3920	3940
Shale, lime	3940	4040
Lime	4040	4090
Lime, chert	4090	4185
Lime	4185	4355
Shale	4355	4437
Chert, Lime	4437	4462
Shale	4462	4553
Lime	4553	4556
Dolomite	4556	4569

T.D.

B.H.P. 1-11-46 1523#

PLUGGING
 FILE SEC 32 T 30 R 13W
 BOOK PAGE 10 LINE 29

Sample Tops:

Douglas Formation	3832
Douglas Sand	3915-25
Douglas Sand	3925-44 (Porous, light to moderat staining)
Lansing	3950
Chert Zone	4442
Kinderhook	4463
Maquoketa	4554