


All Information Completely
Make Required Affidavit
Mail or Deliver Report to:
Conservation Division
State Corporation Commission
800 Biting Building
Wichita, Kansas

WELL PLUGGING RECORD

Barber County. Sec. 32 Twp. 30 Rge. 13 (E) W (W)

Location as "NE/CNW $\frac{1}{4}$ SW $\frac{1}{4}$ " or footage from lines C NW $\frac{1}{4}$
Lease Owner J. M. Huber Corporation
Lease Name Gant Well No. 1
Office Address 916 South Pine St.
Character of Well (completed as Oil, Gas or Dry Hole) Oil
Date well completed 9-5-44 19
Application for plugging filed 5-12-50 19
Application for plugging approved 5-12-50 19
Plugging commenced 5-13-50 19
Plugging completed 5-21-50 19
Reason for abandonment of well or producing formation
Production Exhausted
If a producing well is abandoned, date of last production 19
Was permission obtained from the Conservation Division or its agents before plugging was commenced? Yes

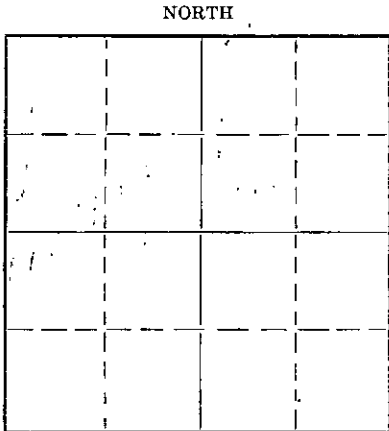

Locate well correctly on above Section Flat

Name of Conservation Agent who supervised plugging of this well Mr. C. D. Stough - Great Bend
Producing formation Depth to top Bottom Total Depth of Well 4670 Feet
Show depth and thickness of all water, oil and gas formations.

OIL, GAS OR WATER RECORDS

CASING RECORD

Formation	Content	From	To	Size	Put In	Pulled Out
				10 3/4"	821'	None
				5 1/2"	4667	3032'

Describe in detail the manner in which the well was plugged, indicating where the mud fluid was placed and the method or methods used in introducing it into the hole. If cement or other plugs were used, state the character of same and depth placed, from feet to feet for each plug set.

Spotted 40 barrels oil behind pipe w/Sun Oil Well Cementing Co. Set fresh water plug at 250' and dumped 20 sacks of cement. Mudded hole to 30' and cemented w/10 sacks of cement.

RECEIVED
JUN 28 1951 6:28.50
NOTARY

(If additional description is necessary, use BACK of this sheet)

Correspondence regarding this well should be addressed to J. M. Huber Corporation
Address Box 460
Pratt, Kansas

STATE OF KANSAS, COUNTY OF PRATT, ss.
I, J. L. Kyler (employee of owner) or ~~Conservation Agent~~ of the above-described well, being first duly sworn on oath, says: That I have knowledge of the facts, statements, and matters herein contained and the log of the above-described well as filed and that the same are true and correct. So help me God.


(Signature) _____

(Address) _____

SUBSCRIBED AND SWORN to before me this 27th day of June, 19 50

My commission expires August 20, 1951

J. L. Kyler
Notary Public.

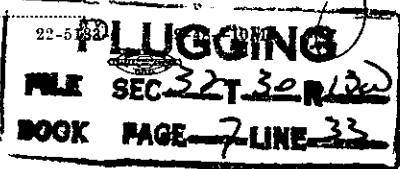

Well Log - Gant #1


C NW $\frac{1}{4}$ - Sec. 32-30S-13W
Barber County, Kansas

Started 7-19-44
Completed 9-5-44

Casing and Tubing Record

10 3/4" set at 821' w/300 sacks of cement
5 1/2" Casing set at 4667 w/200 sacks of cement

Surface Soil	0	100
Red Bed, Shells	100	817
Anhydrite	817	823'
Lime Shells, shale	823	1050'
Red Beds, shells	1050	1330-
Shale, Shells	1330	1490
Shale, Salt	1490	1530
Shale, Lime shells	1530	1980
Lime	1980	2105
Lime, Shale	2105	2195
Lime	2195	2310
Shale, Lime	2310	2400
Lime	2400	2442
Shale, Lime	2442	2570
Lime	2570	2614
Lime, Shale	2614	3104
Sandy shale	3104	3110
Shale, lime	3110	3127
Lime	3127	3248
Lime, shale	3248	3386
Lime	3386	3426
Lime, shale	3426	3560
Lime	3560	3592
Shale, Lime	3592	3786
Lime	3786	3874
Shale, Lime	3874	3894
Lime	3894	3950
Sand	3950	3976
Shale	3976	3979
Lime	3979	4100
Sandy Lime	4100	4149
Lime	4149	4390
Lime	4390	4463
Chert	4463	4405
Lime, Shale	4405	4528
Lime	4528	4555
Lime, shale	4555	4608
Dolomite, chert	4608	4640
Lime	4640	4653
Lime, chert	4653	4670

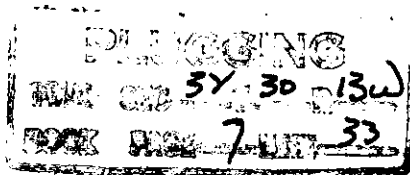

Topeka	3117'	
Douglas	3891'	
Douglas sand	3891-99	sand, very fine, tight, no shows
Douglas sand	3967-80	sand, moderately porous, very faint staining
Douglas sand	3980-93	sand, fair to good porosity, good light staining and faint odor
Lansing	3996	
	4096-04	low porosity, no staining
	4117-37	low porosity, no staining
	4142-52	low porosity, no staining
	4179-85	fair
	4206-13	good
	4228-31	low
Base K.C.	4386	
Chert Zone	4466	
	4475-85	slightly porous chert, trace dead stain
Dolomite	4549-55	very fine, low porosity, good dark oil staining.
Maquoketa	4608-11	dolomite, fine to medium xln, good porosity and stain
Cored	4611-21	recovered 3'6" 3'0" dolomite, in part good porosity and staining
Cored	4621-30	0'6" lime, medium crystalline, slightly chert Recovered 4'0" 4'0" dolomite, tight with few spots porosity and staining
Cored	4630-40	recovered 6'0" 4'0" dolomite, fair to good porosity and staining 2'0" lime, grey coarse xln, trace pink mottling.
Xln Viola	4638	
Cherty Viola	4648	
T.D	4670	

JUN 28 1950
 STATE CORPORATION
 COMMISSION
 KANSAS