

WELL PLUGGING RECORD

STATE OF KANSAS
STATE CORPORATION COMMISSION

Give All Information Completely
Make Required Affidavit
Mail or Deliver Report to:
Conservation Division
State Corporation Commission
800 Bittling Building
Wichita, Kansas

OR FORMATION PLUGGING RECORD

Strike out upper line
when reporting plug-
ging off formations.

Barber County. Sec. 33 Twp. 30 Rge. (E) 13 (W)

Location as "NE $\frac{1}{4}$ NW $\frac{1}{4}$ SW $\frac{1}{4}$ " or footage from lines. 1650' from N line 1650 From W line

Lease Owner Alf. M. Landon Etal

Lease Name Katner Well No. I

Office Address 1019 Central Building Wichita Kansas

Character of Well (completed as Oil, Gas or Dry Hole) Dry Hole

Date well completed August 19 1946 19

Application for plugging filed September 16 1946 Verbal 19

Application for plugging approved September 16 1946 VERBAL Verbal 19


Plugging commenced September 18 1946 19

Plugging completed September 23 1946 19

Reason for abandonment of well or producing formation Dry

If a producing well is abandoned, date of last production X 19

Was permission obtained from the Conservation Division or its agents before plugging was commenced? Yes

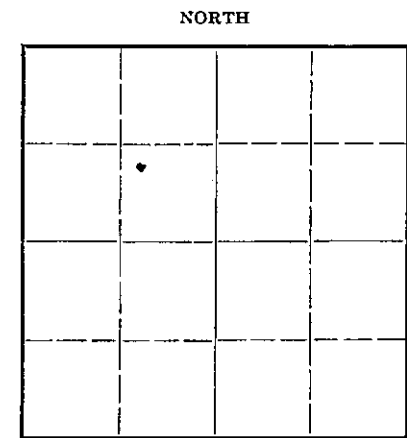

Locate well correctly on above
Section Flat

Name of Conservation Agent who supervised plugging of this well H.W. Kerr

Producing formation None Depth to top X Bottom X Total Depth of Well 4584 Feet

Show depth and thickness of all water, oil and gas formations.

OIL, GAS OR WATER RECORDS

CASING RECORD

| Formation | Content | From | To | Size | Put In | Pulled Out |
|-----------|---------|------|----|---------|--------|------------|
| Surface | | | | 10 3/4" | 890' | None |
| | | | | 5 1/2" | 4576 | 3135' |
| | | | | | | |
| | | | | | | |
| | | | | | | |
| | | | | | | |

Describe in detail the manner in which the well was plugged, indicating where the mud fluid was placed and the method or methods used in introducing it into the hold. If cement or other plugs were used, state the character of same and depth placed, from _____ feet to _____ feet for each plug set.

Dumped 6 Sax cement on bottom filling hole back to 4560'
Pumped heavy mud to 720' Dumped 20 sax cement filling hole from 750' to 710'
Pumped haeavy mud to 200'. Dumped 10 sax cement filling hole from 200' back to 780'
Dumped heavy mud from 180' back to 20' . Dumped 20 sacks cement from 20' back to base of cellar.

33 30 13W
75 29

(If additional description is necessary, use BACK of this sheet)

Correspondence regarding this well should be addressed to Harbar Drilling Company
Address 1019 Central Bldg. Wichita Kansas

STATE CORPORATION COMMISSION
OCT 11 1946
10-11-46

STATE OF Kansas COUNTY OF Barton

Paul Pfeifer (employee of owner) or (owner) of the above-described well,
being first duly sworn on oath, says: That I have knowledge of the facts, statements, and matters herein contained and the log of the above-described well as filed and that the same are true and correct. So help me God

(Signature) Paul Pfeifer

Box 247 Great Bend Kansas
(Address)

SUBSCRIBED AND SWORN to before me this 9 day of October 1946

My commission expires Feb 7 - 1950

Henriette
Notary Public.

ALF M. LONDON, et al
 KEYSER #1

CTR. SW/4 SE/4 NW/4 of Section 33, Twp. 30S, Rge. 13W

Rigged up 6-26-46
 Tearing out rotary tools 7-24-46

Ran 784' of 10-3/4" surface pipe set at 779'
 Ran 4584' of 7" casing set at 4576-1/2"

| FORMATION | FROM | TO |
|---------------------|------|-------------|
| Sand | 0 | 20 |
| Red Rock | 20 | 50 |
| Sand | 50 | 60 |
| Red Bed | 80 | 530 |
| Red Bed & Shells | 530 | 705 |
| Shale | 705 | 778 |
| Anhydrite | 778 | 785 |
| Shale & Shells | 785 | 890 |
| Red Bed | 890 | 1190 |
| Red Bed & Shells | 1190 | 1310 |
| Shale & Shells | 1310 | 1605 |
| Salt | 1605 | 1680 |
| Shale & Lime Shells | 1650 | 1835 |
| Shale & Shells | 1835 | 1895 |
| Lime | 1895 | 1925 |
| Sandy Lime | 1925 | 1940 |
| Soft Lime | 1940 | 2025 |
| Broken Lime | 2035 | 2095 |
| Lime | 2095 | 2430 |
| Shale & Lime | 2430 | 2695 |
| Sand & Shale | 2695 | 2705 |
| Lime & Shale | 2705 | 2830 |
| Lime | 2830 | 2905 |
| Shale & Lime | 2905 | 3060 |
| Lime | 3060 | 3250 |
| Soft Lime | 3250 | 3330 |
| Lime | 3330 | 3575 |
| Lime & Shale | 3575 | 3705 |
| Lime | 3705 | 3905 |
| Shale | 3905 | 3970 |
| Lime | 3970 | 4140 |
| Soft Lime | 4140 | 4150 |
| Lime | 4150 | 4430 |
| Chert & Lime | 4430 | 4440 |
| Lime | 4440 | 4445 |
| Shale | 4445 | 4475 |
| Lime | 4475 | 4490 |
| Shale | 4490 | 4579 |
| | 4579 | Total Depth |

Top Lansing Kansas City 3980
 Top Mississippi 4445
 Top Maquoketa 4579



I, W. A. Grant, certify that, to the best of my knowledge and belief, the above log is true and correct.

[Handwritten Signature]

Subscribed and sworn to before me this

2nd day of September, 1946.

My commission expires April 7, 1947.

[Handwritten Signature]
 Notary Public

PLUGGING
 FILE NO. 33 30R 13W
 BOOK PAGE 75 LINE 29