

15-007-10063-00.00


STATE OF KANSAS
STATE CORPORATION COMMISSION

WELL PLUGGING RECORD

Give All Information Completely
Make Required Affidavit
Mail or Deliver Report to:
Conservation Division
State Corporation Commission
800 Bitting Building
Wichita, Kansas

Barber County, Sec. 36 Twp. 31S Rge. (E) 12(W)

Location as "NE/CNW/SW" or footage from lines NE 1/4 SE 1/4
Lease Owner Sylward Drilling Company
Lease Name Storm Well No. 1
Office Address 813 First Natl. Bank Bldg., Wichita, 2, Kansas.
Character of Well (completed as Oil, Gas or Dry Hole) Gas
Date well completed October 16, 1946. 19
Application for plugging filed June 24, 19 53
Application for plugging approved 19
Plugging commenced June 27, 19 53
Plugging completed June 29, 19 53
Reason for abandonment of well or producing formation Depleted

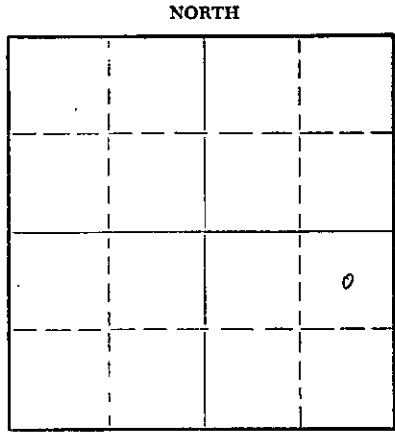

Locate well correctly on above
Section Plat

If a producing well is abandoned, date of last production Nov. 1951. 19
Was permission obtained from the Conservation Division or its agents before plugging was commenced? YES

Name of Conservation Agent who supervised plugging of this well
Producing formation _____ Depth to top _____ Bottom _____ Total Depth of Well 3426 Feet
Show depth and thickness of all water, oil and gas formations.

OIL, GAS OR WATER RECORDS

CASING RECORD

FORMATION	CONTENT	FROM	TO	SIZE	PUT IN	PULLED OUT
				9-5/8"	184'	None
				5-1/2"	3413'	2590'

Describe in detail the manner in which the well was plugged, indicating where the mud fluid was placed and the method or methods used in introducing it into the hole. If cement or other plugs were used, state the character of same and depth placed, from _____ feet to _____ feet for each plug set.

Checked hole, found hole open, loaded casing with water to kill gas, sanded hole from 3413' to 3400', and dumped 5 sacks cement, bailed off fluid, set 10' rock bridge at 300' and dumped 20 sacks cement, mudded to 35' set rock bridge and dumped 10 sacks cement to surface to complete plugging. Well was plugged as per plugging instructions from State Pluggers.

DEPT.
STATE CORP. COM.

CONSERV.

(If additional description is necessary, use BACK of this sheet).

Name of Plugging Contractor West Supply Company
Address Chase, Kansas. 6-10-58

STATE OF KANSAS, COUNTY OF SEDGWICK, ss.
Al Skalsky (employee of owner) or (owner or operator) of the above-described well, being first duly sworn on oath, says: That I have knowledge of the facts, statements and matters herein contained and the log of the above-described well as filed and that the same are true and correct. So help me God.

(Signature) Al Skalsky
813 First Natl. Bank Bldg., Wichita, Kans. (Address)

SUBSCRIBED AND SWORN TO before me this 9th day of July, 19 53

My commission expires _____
AnnaBeth Huffine Notary Public

24-2675-S 2-52-20M

PLUGGING
FILE SEC 36 T 31 R 12W
BOOK PAGE 110 LINE 18

AnnaBeth Huffine
Notary Public
My commission expires April 6, 1955

Notary Public April 6, 1955

STORMS #1

Casing Record:

9-5/8" - 184'
5-1/2" - 3413'

Company: Olson & Globe

Contractor: Olson Drilling Co.

Commenced: September 29, 1946
Completed: October 16, 1946

Location:

C NE SE Sec. 36-31S-12W
Barber County, Kansas

	<u>From</u>	<u>To</u>	
Surface Clay & Sand	0	65	
Sand	65	85	
Brown Shale	85	216	Set 184' 9-5/8" Casing, cemented with 150 sacks
Redbed	216	420	
Red Shale & Shells	420	840	
Shale & Shells	840	1590	
Lime	1590	1675	
Lime Shells & Anhydrite	1675	1780	
Lime & Shale	1780	1885	
Lime	1885	1985	
Lime & Shale	1985	2110	
Lime	2110	2339	
Lime & Shale	2339	2525	
Sandy Lime & Shale	2525	2675	
Shale & Lime	2675	2920	
Lime	2920	3250	
Lime & Shale	3250	3411	
Sand	3411	3426 T.D.	Set 3412' 5-1/2" Casing, cemented with 125 sacks

TOPS:

Elgin 3411 (-1818)

Additional Information:

D.S.T. 3413 - 3421 Open 30' Gas in 10 Min.

PLUGGING
FILE SEC. 36 T. 31 R. 12W
BOOK PAGE 110 LINE 19