

RECEIVED
MAR 2 1977
RECEIVED

STATE OF KANSAS
STATE CORPORATION COMMISSION

WELL PLUGGING RECORD

Give All Information Completely
Make Required Affidavit
Mail or Deliver Report to
Conservation Division
State Corporation Comm.
245 North Water
Wichita, KS 67202

Barber County. Sec. 34 Twp. 31S Rge. 12 E/W
Location as "NE/CNW $\frac{1}{4}$ SW $\frac{1}{4}$ " or footage from lines
510' FSL & 2130' FEL

Lease Owner Texas Oil & Gas Corp.
Lease Name Bauman Well No. 1
Office Address 200 W. Douglas, Suite #300, Wichita KS 67202


Character of Well (Completed as Oil, Gas or Dry Hole)
Dry hole

Date Well completed 2-24-77 19
Application for plugging filed 2-24-77 19
Application for plugging approved 2-24-77 19
Plugging commenced 2-24-77 19
Plugging completed 2-24-77 19
Reason for abandonment of well or producing formation

If a producing well is abandoned, date of last production 19

Was permission obtained from the Conservation Division or its agents before plugging was commenced? Yes

Name of Conservation Agent who supervised plugging of this well J. H. Metz, Stafford KS
Producing formation Depth to top Bottom Total Depth of Well 4542'
Show depth and thickness of all water, oil and gas formations.

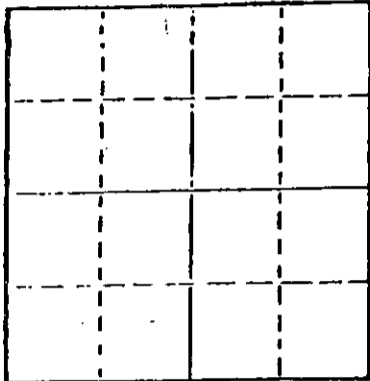

Locate well correctly on above Section Plat

OIL, GAS OR WATER RECORDS

CASING RECORD

FORMATION	CONTENT	FROM	TO	SIZE	PUT IN	PULLED OUT
		0	265'	8 5/8"		

Describe in detail the manner in which the well was plugged, indicating where the mud fluid was placed and the method or methods used in introducing it into the hold. If cement or other plugs were used, state the character of same and depth placed, from feet to feet for each plug set.

Heavy mud from T.D. to 260', 35 sack cement plug mud to 40'
1/2 sack hulls plugged bridge 15 sacks to base of cellar
5 sacks to rat hole

RECEIVED
STATE CORPORATION COMMISSION

MAR 03 1977

CONSERVATION DIVISION
Wichita, Kansas

(If additional description is necessary, use BACK of this sheet)

Name of Plugging Contractor Xplor Drilling Co
P.O. Box 18611 180 S. Rock Road Wichita KS 67207

STATE OF Kansas COUNTY OF Sedgwick, ss.
Wayne L. Kirkman (employee or owner) or (owner or operator)
of the above-described well, being first duly sworn on oath, says: That I have knowledge of the facts, statements, and matters herein contained and the log of the above-described well as filed and that the same are true and correct. So help me God.


(Signature)

Wayne L. Kirkman
180 S. Rock Road, Wichita KS 67207
(Address)

SUBSCRIBED AND SWORN TO before me this 28 day of February, 1977

Virginia Lee Smith, Notary Public.

My commission expires Aug. 25, 1980

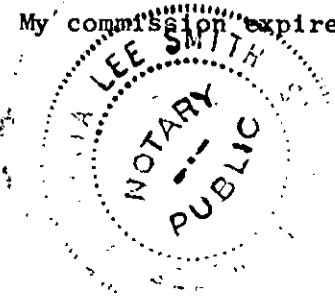

WELL LOG

RECEIVED
MAR 2 1977
RECEIVED

BAUMAN #1
510' FSL & 2130' FEL
Section 34-31S-12W
Barber County Kansas

OPERATOR: TEXAS OIL & GAS CORP. COMMENCED: 2-14-77
CONTRACTOR: XPLOR DRILLING CO. COMPLETED: 2-24-77

CASING RECORD: Ran 6 jts. new 24# 8 5/8" set @265'. Cement with
250 sacks common cement, 2% gel. 3% cal.chloride.

<u>FORMATION</u>	<u>FROM</u>	<u>TO</u>	<u>ELEVATION</u>
Red Bed	0	270	
Red Bed & Shale	270	1761	
Lime & Shale	1761	4387	
Lime	4387	4391	
Shale & Lime	4391	4542	
RTD	4542		

RECEIVED
STATE CORPORATION COMMISSION

MAR 09 1977

CONSERVATION DIVISION
Wichita, Kansas

STATE OF KANSAS)
) SS:
COUNTY OF SEDGWICK)

I certify that this is a true and correct copy of the Driller's log of
the well drilled 510' FSL & 2130" FEL of Section 34-31S-12W, Barber County,
Kansas, to the best of my knowledge and belief.

XPLOR DRILLING CO.

Wayne L. Kirkman
Wayne L. Kirkman, Owner

Subscribed and sworn to before me this 28th. day of February 1977.

MY COMMISSION EXPIRES:
August 25, 1980

Virginia Lee Smith
Virginia Lee Smith, Notary Public

