


WELL PLUGGING RECORD

Give All Information Completely
Make Required Affidavit
Mail or Deliver Report to:
Conservation Division
State Corporation Commission
211 No. Broadway
Wichita, Kansas

Barber County, Sec. 28 Twp. 30S Rge. (E) 15 (W)

NORTH

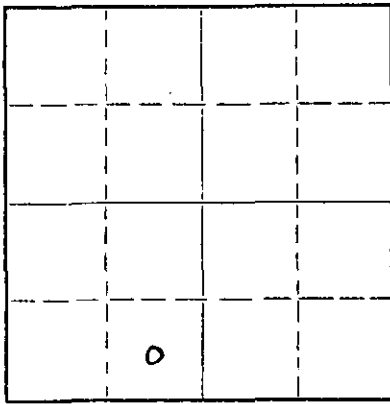

Locate well correctly on above
Section Plat

Location as "NE/CNW/SW" or footage from lines SE SW
Lease Owner Kimbark Exploration Company
Lease Name Riepe Well No. 1
Office Address 201 Univ. Blvd. - Denver, Colo.
Character of Well (completed as Oil, Gas or Dry Hole) Dry Hole
Date well completed 8/24 19 63
Application for plugging filed 8/24 19 63
Application for plugging approved 19
Plugging commenced 8/24 19 63
Plugging completed 8/24 19 63
Reason for abandonment of well or producing formation

If a producing well is abandoned, date of last production 19
Was permission obtained from the Conservation Division or its agents before plugging was commenced?

Name of Conservation Agent who supervised plugging of this well
Producing formation Depth to top Bottom Total Depth of Well 4700 Feet
Show depth and thickness of all water, oil and gas formations.

OIL, GAS OR WATER RECORDS

CASING RECORD

FORMATION	CONTENT	FROM	TO	SIZE	PUT IN	PULLED OUT
		Surf.	1030	8 5/8	550	

Describe in detail the manner in which the well was plugged, indicating where the mud fluid was placed and the method or methods used in introducing it into the hole. If cement or other plugs were used, state the character of same and depth placed, from feet to feet for each plug set.

1000' to 800' - 30 sacks cement
40' to 0 - 15 sacks cement

RECEIVED
STATE CORPORATION COMMISSION

SEP 13 1963

CONSERVATION DIVISION
Wichita, Kansas

(If additional description is necessary, use BACK of this sheet)

Name of Plugging Contractor Same
Address

STATE OF Colorado, COUNTY OF Denver, ss.
W. K. Arbuckle (employee of owner) or (owner or operator) of the above-described well, being first duly sworn on oath, says: That I have knowledge of the facts, statements, and matters herein contained and the log of the above-described well as filed and that the same are true and correct. So help me God.

(Signature) *W. K. Arbuckle*
201 Univ. Blvd. - Denver, Colo.
(Address)

SUBSCRIBED AND SWORN TO before me this 12th day of September, 1963

My commission expires Nov. 15, 1964

Walter P. Nelson
Notary Public.



WELL LOG

COMPANY:
CONTRACTOR:
FARM:
LOCATION:

Kimberk Exploration Company
Bowers Drilling Company, Inc.
Riepe #1
SE SW Section 28-30S-15W
Barber County, Kansas

COMMENCED:
COMPLETED:
ELEVATION:

8-8-63
8-24-63
1732 R.B.

0 - 704	Red Bed
704 - 1200	Red Bed and Shale
1200 - 1381	Shale
1381 - 1865	Shale and lime
1865 - 4290	Lime and shale
4290 - 4306	Lime
4306 - 4471	Lime and shale
4471 - 4572	Lime
4572 - 4590	Chert and lime
4590 - 4679	Lime and shale
4679 - 4693	T.D. Lime

Ran 32 jts. 8 5/8" 24# Surf.csg.
at 1030'

STATE OF KANSAS)
)SS
COUNTY OF SEDGWICK)

I, Emil E. Bowers, do hereby certify that the above and foregoing is a true and correct copy of the copy of the log of the #1 Kelly, C SW NE Section 27-32-19W, Barber County, Kansas, as reflected by the files of Bowers Drilling Company, Inc.

Emil E. Bowers
Emil E. Bowers

Subscribed and sworn to before me, a Notary Public in and for Sedgwick County, Kansas, this 6th day of August, 1963.

Janet C. McLaughlin
Notary Public

My commission expires 8-6-1967

RECEIVED
STATE CORPORATION COMMISSION

SEP 5 1963

CONSERVATION DIVISION
Wichita, Kansas