


WELL PLUGGING RECORD

Give All Information Completely
Make Required Affidavit
Mail or Deliver Report to:
Conservation Division
State Corporation Commission
800 Bitting Building
Wichita, Kansas

NORTH

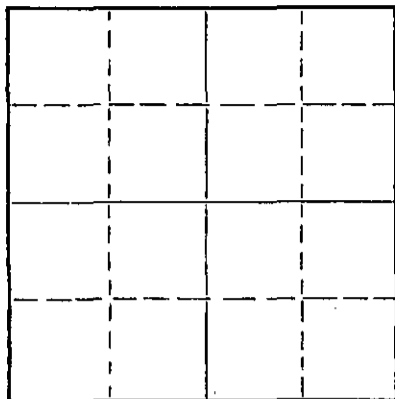

Locate well correctly on above
Section Plat

Barber County. Sec. 14 Twp. 30 Rge. (E) 13 (W)
Location as "NE/CNWxSWx" or footage from lines NE NE SE
Lease Owner Hupp-Ferguson Oil Co.
Lease Name Hittle Well No. 1
Office Address 523 Petroleum Bldg., Wichita, Kansas
Character of Well (completed as Oil, Gas or Dry Hole) Dry Hole
Date well completed 6-13-55 19
Application for plugging filed 6-13-55 19
Application for plugging approved 6-13-55 19
Plugging commenced 6-13-55 19
Plugging completed 6-13-55 19
Reason for abandonment of well or producing formation

If a producing well is abandoned, date of last production 19
Was permission obtained from the Conservation Division or its agents before plugging was commenced? Yes

Name of Conservation Agent who supervised plugging of this well M. A. Rives
Producing formation Depth to top Bottom Total Depth of Well 4705 Feet
Show depth and thickness of all water, oil and gas formations.

OIL, GAS OR WATER RECORDS

CASING RECORD

FORMATION	CONTENT	FROM	TO	SIZE	PUT IN	PULLED OUT
				8 5/8	341	-0-

Describe in detail the manner in which the well was plugged, indicating where the mud fluid was placed and the method or methods used in introducing it into the hole. If cement or other plugs were used, state the character of same and depth placed, from feet to feet for each plug set.

Filled hole w/mud to 300', 1/4 sx hulls - plug - 20 sx cement thru drill pipe.
Fill w/mud to 35', 1/4 sx hulls - plug - hulls - 10 sx cement.

RECEIVED
STATE CORPORATION COMMISSION

JUN 21 1955 6-21-55

CONSERVATION DIVISION
WICHITA, KANSAS

(If additional description is necessary, use BACK of this sheet)

Name of Plugging Contractor Rupp-Ferguson Oil Co.
Address 523 Petroleum Bldg., Wichita, Kansas

STATE OF Kansas, COUNTY OF Sedgwick, ss.
L. W. Knox (employee of owner) or (owner or operator) of the above-described well, being first duly sworn on oath, says: That I have knowledge of the facts, statements, and matters herein contained and the log of the above-described well as filed and that the same are true and correct. So help me God.

(Signature) *L. W. Knox*
523 Petroleum Bldg., Wichita, Kansas
(Address)

SUBSCRIBED AND SWORN TO before me this 20th day of June, 19 55

Helen Horine
Notary Public.

My commission expires 6-4-59

PLUGGING
FILE SEC 14 T 30 R 136
BOOK PAGE 126 LINE 45

CONTRACTOR'S WELL LOG

Rupp-Ferguson No. 1 Hittle
NE NE SE, Sec. 14-30-13W,
Barber County, Kansas

Elev. 1795 KB

D & A

Set 8 5/8" surface casing @ 341' w/275 sacks cement

Commenced: 5-25-55
Completed: 6-13-55
Contractor: Rupp-Ferguson Oil Co.

Figures Indicate Bottom of Formation:

60 sand & gravel
885 red bed
1325 shale & shells
1550 salt & shale
1775 shale, lime streaks
1900 lime & shale
1980 lime
2110 lime & shale
2215 lime
2335 lime, shale streaks
3682 lime & shale
3760 lime & sand
3830 lime & shale
4230 lime
4278 lime & shale
4285 lime
4341 Miss.
4379 cherty lime
4458 shale
4564 Viola
4639 Simpson
4675 shale & sand
4705 Arb.
T.D.

Tops:
(Elec. log)
Heebner 3669 (-1874)
Douglas 3726 (-1931)
Brown Lime 3830 (-2035)
Lansing-Kansas City 3843 (-2048)
Mississippian 4284 (-2489)
Kinderhook 4379 (-2584)
Viola 4455 (-2660)
Simpson Shale 4575 (-2780)
Simpson Sand 4592 (-2797)
Arbuckle 4674 (-2879)
Total Depth 4705 (-2910)

STATE OF KANSAS)
) SS:
SEDGWICK COUNTY)

RECEIVED
STATE CORPORATION COMMISSION
JUN 21 1955
CONSERVATION DIVISION
Wichita, Kansas

I, L. W. Knox, Landman for Rupp-Ferguson Oil Co., do hereby certify that the above and foregoing is a true and correct copy of the log of the No. 1 Hittle well.

L. W. Knox
L. W. Knox

Subscribed and sworn to before me this 20th day of June, 1955.

Helen Horine
Notary Public

My Commission Expires June 4, 1959.

PLUGGING
FILE SEC 14 T 30 R 13W
BOOK PAGE 126 LINE 15