

WELL PLUGGING RECORD


Give All Information Completely
Make Required Affidavit
Mail or Deliver Report to:
Conservation Division
State Corporation Commission
212 North Market, Insurance Bldg.
Wichita, Kansas

Barber

County. Sec. 32 Twp. 31 Rge. (E) 12 (W)

Location as "NE/CNW/SW" or footage from lines NE NE SW
Lease Owner Aylward Drilling Company
Lease Name Wright Well No. 1
Office Address 813 1st Nat'l Bank Bldg. - Wichita 2, Kansas
Character of Well (completed as Oil, Gas or Dry Hole) Dry
Date well completed April 9 1961
Application for plugging filed April 9 1961
Application for plugging approved April 9 1961
Plugging commenced April 9 1961
Plugging completed April 9 1961
Reason for abandonment of well or producing formation _____

NORTH

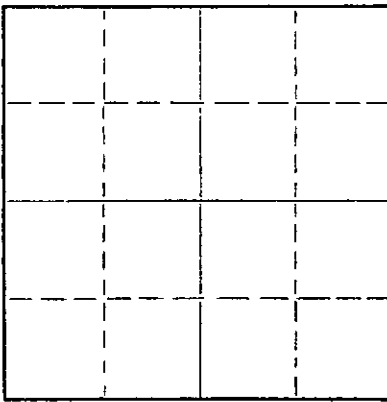

Locate well correctly on above
Section Plat

If a producing well is abandoned, date of last production _____ 19____
Was permission obtained from the Conservation Division or its agents before plugging was commenced? Yes

Name of Conservation Agent who supervised plugging of this well Fred Hampel
Producing formation _____ Depth to top _____ Bottom _____ Total Depth of Well 4385 Feet
Show depth and thickness of all water, oil and gas formations.

OIL, GAS OR WATER RECORDS

CASING RECORD

FORMATION	CONTENT	FROM	TO	SIZE	PUT IN	PULLED OUT
				8 5/8"	214	None

Describe in detail the manner in which the well was plugged, indicating where the mud fluid was placed and the method or methods used in introducing it into the hole. If cement or other plugs were used, state the character of same and depth placed, from _____ feet to _____ feet for each plug set.

Mud to 210', plug at 210' with 15 sacks cement
Mud to 35', plug at 35' with 10 sacks cement

RECEIVED
STATE CORPORATION COMMISSION

MAY 25 1961

CONSERVATION DIVISION
Wichita, Kansas

(If additional description is necessary, use BACK of this sheet)

Name of Plugging Contractor Aylward Drilling Company
Address _____

STATE OF KANSAS, COUNTY OF SEDGWICK, ss.
Paul W. Hesse (employee of owner) of the above-described well, being first duly sworn on oath, says: That I have knowledge of the facts, statements, and matters herein contained and the log of the above-described well as filed and that the same are true and correct. So help me God.

(Signature) Paul W. Hesse
813 1st Nat'l Bank Bldg., Wichita 2, Kansas
(Address)

SUBSCRIBED AND SWORN to before me this 20th day of April, 1961

My commission expires December 11, 1961
Duane Jessup Notary Public.



WRIGHT NO. 1

Casing Record: Company: Aylward Drilling Company and Location: NE NE SW
8 5/8" - 214' Sunray Mid-Continent Oil Company Sec. 32-31-12W
Contractor: Aylward Drilling Company Barber County
Kansas
Commenced: March 27, 1961
Completed: April 8, 1961 Elev. 1547 DF - 1550 KB

	<u>From</u>	<u>To</u>	<u>Remarks</u>
Sand	0	70	Set 8 5/8" surface pipe @ 214' w/150 sacks cement.
Red Bed and Shale	70	214	
Shale & Lime	214	375	Geological Tops: (Log)
Red Bed, Shale & Sand	375	815	
Shale	815	1570	Elgin Sandstone 3356
Lime	1570	1970	Heebner 3506
Shale & Shells	1970	2060	Toronto 3520
Shale & Lime	2060	2430	Douglas 3542
Lime & Shale	2430	2555	Upper Douglas Sandstone 3558
Shale & Lime	2555	3084	Lower Douglas Sandstone 3648
Lime & Shale	3084	3244	Brown Limestone 3677
Shale & Lime	3244	3430	Lansing 3699
Sandy Lime & Shale	3430	3500	Mississippi Chert 4226
Lime & Shale	3500	3616	Mississippi Limestone 4261
Shale & Sand	3616	3679	Kinderhook 4350
Lime	3679	4199	
Lime & Chert	4199	4245	
Lime	4245	4282	DST 4227-4385 Mis-run
Chert & Lime	4282	4329	
Lime	4329	4355	DST 4229-80 Open 1 1/2 hr.
Lime & Shale	4355	4385 T.D.	Rec. 20' mud IBHP 100#/45" - FBHP 84#/60" FP 48#-54#

DST 3330-3480 Open 1 1/2 hr.
Rec. 190' mud
IBHP 575#/45" - FBHP 893#/60"
FP 68#-110#

D & A

RECEIVED
STATE CORPORATION COMMISSION

MAY 25 1961

CONSERVATION DIVISION

I hereby certify that this is a true and correct copy of the log to the best of my knowledge.

Paul W. Hesse

Subscribed and sworn to before me this 21st day of April, 1961

Duane Jessup
DUANE JESSUP Notary Public

My commission expires December 11, 1961