


STATE OF KANSAS  
STATE CORPORATION COMMISSION

WELL PLUGGING RECORD

Give All Information Completely  
Make Required Affidavit  
Mail or Deliver Report to:  
Conservation Division  
State Corporation Commission  
800 Bitting Building  
Wichita, Kansas

Babber County, Sec. 10 Twp. 32 Rge. 12 (E) (W)

Location as "NE/CNW/SW" or footage from lines SE SE NW  
Lease Owner Musgrove Petroleum Corporation  
Lease Name Fitzsimmons Well No. 1  
Office Address 518 Petroleum Building  
Character of Well (completed as Oil, Gas or Dry Hole) Dry hole  
Date well completed January 12, 19 53  
Application for plugging filed January 15 19 53  
Application for plugging approved \_\_\_\_\_ 19 \_\_\_\_\_  
Plugging commenced January 12, 19 53  
Plugging completed January 12, 19 53  
Reason for abandonment of well or producing formation Dry

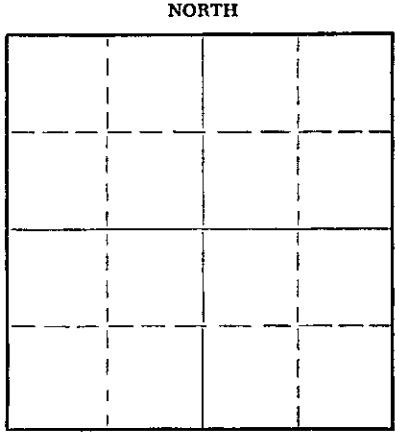

Locate well correctly on above  
Section Plat

If a producing well is abandoned, date of last production \_\_\_\_\_ 19 \_\_\_\_\_  
Was permission obtained from the Conservation Division or its agents before plugging was commenced? \_\_\_\_\_

Name of Conservation Agent who supervised plugging of this well Unknown  
Producing formation \_\_\_\_\_ Depth to top \_\_\_\_\_ Bottom \_\_\_\_\_ Total Depth of Well 4551 Feet  
Show depth and thickness of all water, oil and gas formations.

OIL, GAS OR WATER RECORDS

CASING RECORD

FORMATION	CONTENT	FROM	TO	SIZE	PUT IN	PULLED OUT
				8 5/8"	256'	

Describe in detail the manner in which the well was plugged, indicating where the mud fluid was placed and the method or methods used in introducing it into the hole. If cement or other plugs were used, state the character of same and depth placed, from \_\_\_\_\_ feet to \_\_\_\_\_ feet for each plug set.

Set bottom plug at 240' with 15 sacks of cement.  
Set top plug at 35' with 10 sacks of cement and 1/2 sack of hulls

RECEIVED  
STATE CORPORATION COMMISSION  
JAN 16 1953 1-16-53  
CONSERVATION DIVISION  
Wichita, Kansas

(If additional description is necessary, use BACK of this sheet)  
Name of Plugging Contractor Musgrove Petroleum Corporation  
Address 518 Petroleum Building, Wichita, Kansas

STATE OF Kansas, COUNTY OF Sedgwick, ss.  
Gordon L. Koelling (employee of owner) or (owner or operator) of the above-described well, being first duly sworn on oath, says: That I have knowledge of the facts, statements, and matters herein contained and the log of the above-described well as filed and that the same are true and correct. So help me God.

(Signature) Gordon L. Koelling  
518 Petroleum Bldg, Wichita, Kansas  
(Address)

SUBSCRIBED AND SWORN TO before me this 15th day of January, 19 53  
Mary L. Summ  
Notary Public.

My commission expires November 14, 1956

PLUGGING  
FILE SEC 10 T 32 R 12  
BOOK PAGE 72 LINE 32

CONTRACTOR'S WELL LOG

COMPANY: Musgrove Petroleum Corporation  
CONTRACTOR: Musgrove Petroleum Corporation  
FARM: Fitzsimmons #1  
LOCATION: SE SE NW Section 10-32-12  
Barber County, Kansas

COMMENCED: December 19, 1952  
COMPLETED: January 12, 1953


0	40	Clay
40	75	Red bed and shale
75	85	Sand
85	249	Red bed and shale
249	683	Red bed
683	1298	Red bed and shale and shells
1298	1380	Shale and shells
1380	1485	Lime and shale
1485	1515	Shale
1515	1570	Anhydrite
1570	3778	Lime and shale
3778	4257	Lime
4257	4282	Mississippi Lime
4282	4353	Lime
4353	4435	Cherty lime and shale
4435	4551	Lime and shale
	4551	Rotary Total Depth

Set 256' of 8 5/8" casing and cemented with 150 sacks of cement.

Dry and abandoned.

STATE OF KANSAS )  
                          ) SS  
COUNTY OF SEDGWICK )

I, GORDON L. KOELLING, do hereby certify that the above and foregoing is a true and correct copy of the log of the Fitzsimmons #1, Section 10-32-12, Barber County, Kansas, as reflected by the files of the Musgrove Petroleum Corporation.

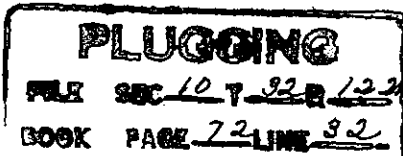

MUSGROVE PETROLEUM CORPORATION

By Gordon L. Koelling  
Secretary-Treasurer

Subscribed and sworn to before me a Notary Public in and for Sedgwick County, Kansas, this 15th day of January, 1953.

My Commission Expires: November 14, 1956.

Mary L. Lunn  
Notary Public  
STATE COMMISSION COMMISSION  
JAN 16 1953  
CONSERVATION DIVISION  
Wichita, Kansas