

STATE OF KANSAS
STATE CORPORATION COMMISSION


WELL PLUGGING RECORD

Give All Information Completely
Make Required Affidavit
Mail or Deliver Report to:
Conservation Division
State Corporation Commission
800 Bittling Building
Wichita, Kansas

Barber County. Sec. 10 Twp. 32 Rge. (E) 12 (W)

Location as "NE/CNWxSWx" or footage from lines SE NE NE
Lease Owner Musgrove Petroleum Corporation
Lease Name SUSIE SMITH Well No. 2
Office Address 518 Petroleum Building, Wichita, Kansas.
Character of Well (completed as Oil, Gas or Dry Hole) Dry
Date well completed January 16, 1955
Application for plugging filed verbally - January 15, 1955
Application for plugging approved verbally - January 15, 1955
Plugging commenced January 16, 1955
Plugging completed January 16, 1955
Reason for abandonment of well or producing formation Dry

NORTH

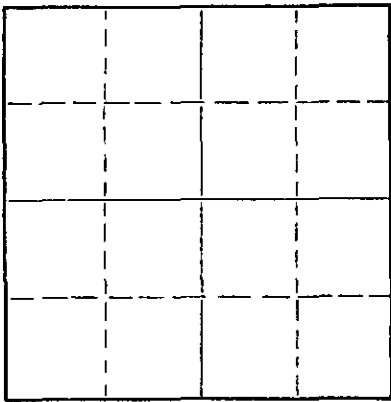

Locate well correctly on above
Section Plat

If a producing well is abandoned, date of last production 19
Was permission obtained from the Conservation Division or its agents before plugging was commenced? verbally - yes. Written 1-17-55

Name of Conservation Agent who supervised plugging of this well M. A. Rives, Box 8, Pratt, Kansas.
Producing formation _____ Depth to top _____ Bottom _____ Total Depth of Well 4324' Feet
Show depth and thickness of all water, oil and gas formations.

OIL, GAS OR WATER RECORDS

CASING RECORD

FORMATION	CONTENT	FROM	TO	SIZE	PUT IN	PULLED OUT
				8-5/8"	171'	

Describe in detail the manner in which the well was plugged, indicating where the mud fluid was placed and the method or methods used in introducing it into the hole. If cement or other plugs were used, state the character of same and depth placed, from _____ feet to _____ feet for each plug set.

Filled hole w/heavy mud to 170'
Set first plug & solid bridge at 170' w/20 sx cement.
Filled hole w/heavy mud to 35'.
Set second plug @ 35' w/10 sx cement.

(If additional description is necessary, use BACK of this sheet)
Name of Plugging Contractor Musgrove Petroleum Corporation
Address 518 Petroleum Building, Wichita, Kansas.


STATE OF Kansas COUNTY OF Sedgwick ss.
Gordon L. Koelling, (employee of owner) or (owner/operator) of the above-described well, being first duly sworn on oath, says: That I have knowledge of the facts, statements, and matters herein contained and the log of the above-described well as filed and that the same are true and correct. So help me God.

(Signature) *Gordon L. Koelling*
518 Petroleum Building, Wichita, Kansas.
(Address)

SUBSCRIBED AND SWORN TO before me this 19th day of January 1955

Thelma D. Steinman
Notary Public.

My commission expires September 24, 1956.

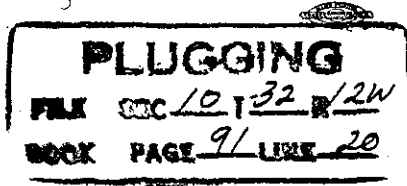

1-21-55

CONTRACTOR'S WELL LOG

COMPANY: Musgrove Petroleum Corporation
CONTRACTOR: Musgrove Petroleum Corporation
FARM: SUSIE SMITH #2
LOCATION: SE NE NE, Sec. 10-32-12,
Barber County, Kansas.
COMMENCED: January 3, 1955
COMPLETED: January 16, 1955

0	150	Surface soil, sand & gyp
150	171	Shale
171	490	Red bed, shale & shells
490	630	Red bed & shells
630	645	Anhydrite
645	1570	Shale & shells
1570	1750	Lime
1750	3075	Lime & shale
3075	3145	Lime
3145	3674	Lime & shale
3674	4247	Lime
4247	4258	Mississippi lime & chert
4258	4278	Mississippi
4278	4324	Lime & chert
	4324	Rotary Total Depth

Set 8-5/8" surface pipe at 171' with 125 sacks of cement and 2 calcium chloride.

Dry and Abandoned.

STATE OF KANSAS)
) SS
COUNTY OF SEDGWICK))

I, GORDON L. KOELLING, do hereby certify that the above and foregoing is a true and correct copy of the log of the SUSIE SMITH #2, SE NE NE, Section 10-32-12, Barber County, Kansas, as reflected by the files of the Musgrove Petroleum Corporation.

MUSGROVE PETROLEUM CORPORATION

BY *Gordon L. Koelling*
Secretary-Treasurer

Subscribed and sworn to before me, a Notary Public, in and for Sedgwick County, Kansas, this 19th day of January, 1955.

Shelma P. Stumpp
Notary Public

My commission expires September 24, 1956.

