


STATE OF KANSAS
STATE CORPORATION COMMISSION

WELL PLUGGING RECORD

Give All Information Completely
Make Required Affidavit
Mail or Deliver Report to:
Conservation Division
State Corporation Commission
211 No. Broadway
Wichita, Kansas

NORTH

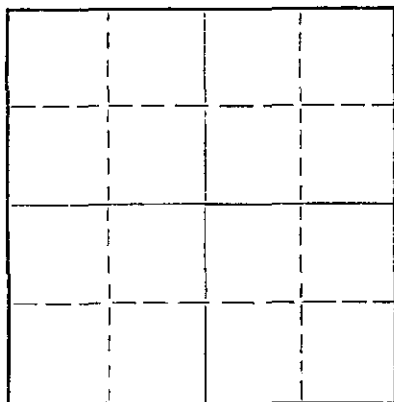

Locate well correctly on above
Section Plat

Barber County. Sec. 7 Twp. 32 S Rge. 12 ~~(E)~~ (W)
Location as "NE/CNW/SW" or footage from lines NW SE SW
Lease Owner Sierra Petroleum Co., Inc.
Lease Name AUBLEY Well No. 1
Office Address 420 W. Douglas Ave., Wichita, Kansas
Character of Well (completed as Oil, Gas or Dry Hole) Dry
Date well completed 10/4/56 19__
Application for plugging filed 10/3/56 19__
Application for plugging approved 10/3/56 19__
Plugging commenced 10/4/56 19__
Plugging completed 10/4/56 19__
Reason for abandonment of well or producing formation Dry

If a producing well is abandoned, date of last production _____ 19__
Was permission obtained from the Conservation Division or its agents before plugging was commenced? yes

Name of Conservation Agent who supervised plugging of this well M. A. Rives
Producing formation _____ Depth to top _____ Bottom _____ Total Depth of Well _____ Feet
Show depth and thickness of all water, oil and gas formations.

OIL, GAS OR WATER RECORDS

CASING RECORD

FORMATION	CONTENT	FROM	TO	SIZE	PUT IN	PULLED OUT
				8 5/8	221	none

Describe in detail the manner in which the well was plugged, indicating where the mud fluid was placed and the method or methods used in introducing it into the hole. If cement or other plugs were used, state the character of same and depth placed, from _____ feet to _____ feet for each plug set.

PLUGGING RECORD

Filled hole from 4328 to 220 with heavy rotary mud. Set wood plug at 220' with 1/2 sacks hulls and 20 sacks cement through drill pipe up to 170'. Filled with heavy mud from 170' up to 35#. Set wood plug at 35' with half sack hulls and 10 sacks cement up to cellar 0. Job completed 4:00 a.m.

(If additional description is necessary, use BACK of this sheet)

Name of Plugging Contractor Sierra Petroleum Co., Inc.
Address 420 W. Douglas Ave., Wichita, Kansas

STATE OF KANSAS, COUNTY OF RUSSELL, ss.
C. T. Honaker (employee of owner) or (owner or operator) of the above-described well, being first duly sworn on oath, says: That I have knowledge of the facts, statements, and matters herein contained and the log of the above-described well as filed and that the same are true and correct. So help me God.

(Signature) C. T. Honaker

(Address)

SUBSCRIBED AND SWORN TO before me this 5th day of October, 1956

My commission expires 1-30-57.

Margie Cooper

Notary Public.

PLUGGING
FILE SEC. 7 T. 32 S R. 12 W
BOOK PAGE 105 LINE 4

RECEIVED
STATE CORPORATION COMMISSION
OCT 8 1956 10-8-56

SIERRA PETROLEUM CO., INC.
AUBLEY #1

NW SE SW Sec. 7-32S-12W.
Barber County, Kansas

Total Depth: 4328'

Elev: 1534 KB

Comm: 9/19/56
Comp: 10/4/56

Casings:

221' of 8 5/8 set with 135 sks cement

FORMATION	DEPTH
Sand	90
Red Rock - Shale - Gyp	221
Red Bed - Shale	325
Shale - Red Bed	515
Shale - Shells	925
Shale	1385
Anhydrite	1420
Shale - Lime - Shells	1600
Gyp - Lime	1745
Lime - Shale	3720
Lime	4328

Tops:	Anhydrite	1385
	Elgin	3442
	Heebner	3552
	Toronto	3565
	Kansas City	3720
	Mississippi	4254

STATE OF KANSAS)
) ss:
COUNTY OF RUSSELL)

I hereby certify that the above information is true and correct to the best of my knowledge.

O. P. Honaker

Subscribed and sworn to before me this 5th day of October, 1956

Margie Cooper
Notary Public

My commission expires: 1-30-57.

PLUGGING	
FILE	SEC. 7 T 32S R 12W
BOOK	PAGE 105 LINE 4

RECEIVED
STATE CORPORATION COMMISSION

OCT 10 1956