


STATE OF KANSAS
STATE CORPORATION COMMISSION
CONSERVATION DIVISION
P. O. BOX 17027
WICHITA, KANSAS 67217

FORM CP-4

WELL PLUGGING RECORD

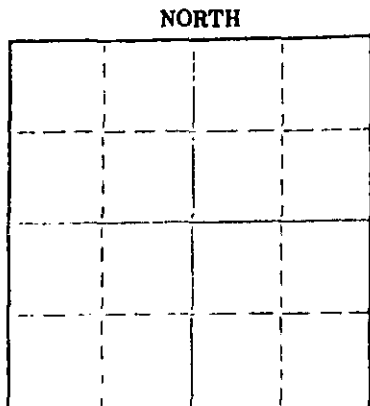

Locate well correctly on above Section Plot

Barber County, Sec. 6 Twp. 32S Rge. (E) 12 (W)
Location as "NE/CNW/SE" or footage from lines 330' ENL & 660' FEL of NE/4
Lease Owner Mid-Continent Energy Corporation
Lease Name Simpson Well No. 1
Office Address 712 One Twenty Building - Wichita, Kansas 67202
Character of Well (completed as Oil, Gas or Dry Hole) Dry Hole
Date well completed May 8, 1978
Application for plugging filed May 8, 1978
Application for plugging approved May 8, 1978
Plugging commenced May 8, 1978
Plugging completed May 8, 1978
Reason for abandonment of well or producing formation dry hole

If a producing well is abandoned, date of last production 19
Was permission obtained from the Conservation Division or its agents before plugging was commenced? yes

Name of Conservation Agent who supervised plugging of this well Bill Owen - Pratt, Kansas
Producing formation _____ Depth to top _____ Bottom _____ Total Depth of Well 4270 feet
Show depth and thickness of all water, oil and gas formations.

OIL, GAS OR WATER RECORDS				CASING RECORD		
FORMATION	CONTENT	FROM	TO	SIZE	PUT IN	PULLED OUT
	Surface Casing	0	239	8 5/8	239	none

Describe in detail the manner in which the well was plugged, indicating where the mud fluid was placed and the method or methods used in introducing it into the hole. If cement or other plugs were used, state the character of same and depth placed, from _____ feet to _____ feet for each plug set.

Plugged with 40 sacks cement at 240',
12 sacks cement at 40', 3 sacks in
rat hole. Job completed at 5:15 A.M.
May 8, 1978.

Name of Plugging Contractor Search Drilling Company
Address Wichita, Kansas
(If additional description is necessary, use BACK of this sheet)


STATE OF Kansas COUNTY OF Sedgwick ss.

_____, (employee of owner) or (owner or operator) of the above-described well, being first duly sworn on oath, says: That I have knowledge of the facts, statements, and matters herein contained and the log of the above-described well as filed and that the same are true and correct. So help me God.

(Signature) W. J. Froelich, Jr.
W. J. Froelich, Jr. Wichita, Kansas
(Address)

SUBSCRIBED AND SWORN TO before me this 9th day of May 1978

My commission expires February 22, 1981
Maxine Dressen Notary Public

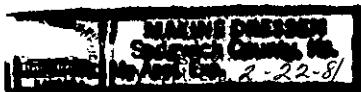

RECEIVED
STATE CORPORATION COMMISSION
MAY 11 1978
CONSERVATION DIVISION
Wichita, Kansas

DRILLERS LOG

SIMPSON #1

CASING RECORD:
8 5/8" set at 239'
with 250 sacks cement

OPERATOR: Mid-Continent Energy Corp.

DESCRIPTION:

330' FNL & 660' FEI
of NE/4 of
Section 6-32S-12W,
Barber County,
Kansas

TOTAL DEPTH:
4270'

CONTRACTOR: Search Drilling Company

COMMENCED: May 1, 1978

COMPLETED: May 8, 1978

<u>FORMATION</u>	<u>FROM</u>	<u>TO</u>	<u>REMARKS</u>
Sand	0	68	
Red Bed	68	250	
Red Bed and Shale	250	1330	
Lime and Shale	1330	1794	
Lime and Shale	1794	2536	
Lime and Shale	2536	3320	
Lime and Shale	3320	4037	
Lime and Shale	4037	4211	
Lime and Shale	4211	4270	
Rotary Total Depth			Dry and Abandoned

RECEIVED
STATE CORPORATION COMMISSION

MAY 11 1978

CONSERVATION DIVISION
Wichita, Kansas

I certify that this is a true and correct copy of the above log to the best of my knowledge.

SEARCH DRILLING COMPANY

W. J. Froelich, Jr.
W. J. Froelich, Jr.

Subscribed and sworn to before me this 9th day of May, 1978.

My appointment expires:
February 22, 1981

Maxine Dressen
Maxine Dressen Notary Public

