


STATE OF KANSAS  
STATE CORPORATION COMMISSION

Give All Information Completely  
Make Required Affidavit  
Mail or Deliver Report to:  
Conservation Division  
State Corporation Commission  
800 Bittling Building  
Wichita, Kansas

## WELL PLUGGING RECORD

NORTH

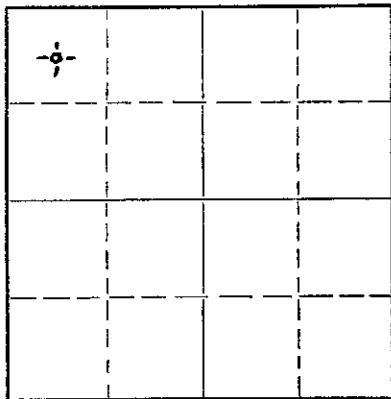

Locate well correctly on above  
Section Plat

Barber County, Sec. 6 Twp. 32 Rge. 12 ~~NE~~ (W)  
Location as "NE/CNW/SW" or footage from lines C NW/4 NW/4  
Lease Owner Pryor & Tracy  
Lease Name Wilson Well No. 1  
Office Address 811 Union National Building  
Character of Well (completed as Oil, Gas or Dry Hole) Dry Hole  
Date well completed 10/11 19 55  
Application for plugging filed 10/11 19 55  
Application for plugging approved 10/11 19 55  
Plugging commenced 10/12 19 55  
Plugging completed 10/12 19 55  
Reason for abandonment of well or producing formation Dry Hole

If a producing well is abandoned, date of last production 19  
Was permission obtained from the Conservation Division or its agents before plugging was commenced? Yes

Name of Conservation Agent who supervised plugging of this well M. A. Rives  
Producing formation Depth to top Bottom Total Depth of Well 4700 Feet  
Show depth and thickness of all water, oil and gas formations.

## OIL, GAS OR WATER RECORDS

## CASING RECORD

FORMATION	CONTENT	FROM	TO	SIZE	PUT IN	PULLED OUT
TD drilled 50' into the Arbuckle				8 5/8"	201'	

Describe in detail the manner in which the well was plugged, indicating where the mud fluid was placed and the method or methods used in introducing it into the hole. If cement or other plugs were used, state the character of same and depth placed, from feet to feet for each plug set.

Filled up with heavy mud to 200', Halliburton plug at 200', 1/3 sack hulls, 20 sacks cement, filled with heavy mud to 35', Halliburton plug, 1/3 sack hulls, and 16 sacks cement.

(If additional description is necessary, use BACK of this sheet)

Name of Plugging Contractor D & M Drilling Company, Inc.  
Address P. O. Box 247, Great Bend, Kansas

STATE OF Kansas, COUNTY OF Barton, ss.

W. M. Barnett (employee of owner) or (owner or operator) of the above-described well, being first duly sworn on oath, says: That I have knowledge of the facts, statements, and matters herein contained and the log of the above-described well as filed and that the same are true and correct. So help me God.

(Signature)

P. O. Box 247, Great Bend, Kansas  
(Address)


SUBSCRIBED AND SWORN to before me this 12th day of October, 19 55

My commission expires July 29, 1957

Notary Public.

24-7366-8

3/53-20M

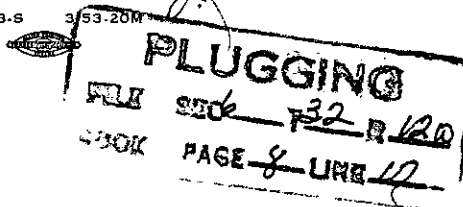

10-14-55

WILSON #1

NW/4 NW/4 of Section 6-32S-12W Barber County, Kansas

Rigged up Rotary Tools 9/22/55

Ran 10 Jts. (206.51') used 8 5/8"

Tore down Rotary Tools 10/12/55

28# surface pipe set at 201'. Cement-  
ed with 150 sacks cement, 2 sacks CC

<u>FORMATION</u>	<u>FROM</u>	<u>TO</u>
Shale & sod	0'	15'
Sand	15	35
Shale & sand	35	201
Redbed & shells	201	645
Shale, shells & sand	645	1255
Anhydrite	1255	1277
Shale & shells	1277	1372
Shale, shells w/lime streaks	1372	1630
Lime & shale streaks	1630	1900
Broken Lime	1900	2009
Lime w/shale streaks	2009	2185
Broken Lime	2185	2255
Shale w/lime streaks	2255	2318
Lime & shale	2318	2468
Sandy shale w/lime streaks	2468	2779
Shale & lime	2779	2847
Lime w/shale streaks	2847	2885
Shale w/lime & sand streaks	2885	3045
Lime w/shale streaks	3045	3140
Broken Lime	3140	3200
Shale & sand w/lime streaks	3200	3465
Lime w/shale streaks	3465	3573
Shale & sand	3573	3620
Broken lime & sand	3620	3650
Sand	3650	3666
Lime	3666	3685
Lime w/shale streaks	3685	3745
Lime	3745	3778
Lime & shale	3778	3894
Lime	3894	4012
Lime w/shale streaks	4012	4072
Lime & shale	4072	4085
Lime w/shale streaks	4085	4132
Lime & shale	4132	4185
Lime & shale w/some chert	4185	4225
Lime & chert	4225	4230
Lime, shale & chert	4230	4257
Shale & chert	4257	4297
Lime & chert streaks	4297	4327
Chert, Lime & shale	4327	4348
Lime & shale	4348	4420
Shale & lime	4420	4452
Shale & sand	4452	4530
Sand & shale	4530	4540
Sand	4540	4594
Lime & shale	4594	4647
Lime	4647	4700 T.D.

I, Don S. Packer, do hereby certify that the foregoing log is true and correct, to the best of my knowledge and belief.

Subscribed and sworn to before me this 13th day of October, 1955

My Commission expires: July 29, 1957

