


WELL PLUGGING RECORD

Give All Information Completely  
Make Required Affidavit  
Mail or Deliver Report to:  
Conservation Division  
State Corporation Commission  
800 Bitting Building  
Wichita, Kansas

NORTH

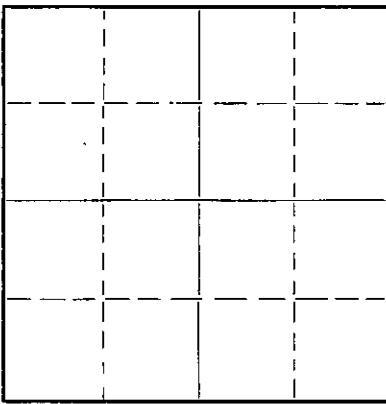

Locate well correctly on above  
Section Plat

Barber County, Sec. 20 Twp 30S Rge (E) 15 (W)

Location as "NE/CNW/SW" or footage from lines SE-NE-SW  
Lease Owner Harry Gore  
Lease Name Clawson Well No. 1  
Office Address 400 Brown Bldg. Wichita 2, Kansas.  
Character of Well (completed as Oil, Gas or Dry Hole) Dry Hole  
Date well completed March 4th, 1950  
Application for plugging filed March 5th, 1950  
Application for plugging approved March 5th 19 50  
Plugging commenced March 5th 19 50  
Plugging completed March 5th, 19 50  
Reason for abandonment of well or producing formation

If a producing well is abandoned, date of last production 19  
Was permission obtained from the Conservation Division or its agents before plugging was commenced? YES

Name of Conservation Agent who supervised plugging of this well C. D. Stough  
Producing formation Depth to top Bottom Total Depth of Well 4460 Feet  
Show depth and thickness of all water, oil and gas formations.

OIL, GAS OR WATER RECORDS

CASING RECORD

Formation	Content	From	To	Size	Put In	Pulled Out
				8 5/8"	787	None

Describe in detail the manner in which the well was plugged, indicating where the mud fluid was placed and the method or methods used in introducing it into the hole. If cement or other plugs were used, state the character of same and depth placed, from feet to feet for each plug set.

Filled Hole with heavy mud to 250 Feet. Set Wood Plug at 250 feet Then 15 Sacks Cement on top of Plug, then with heavy mud to 30 feet, then Wood Plug, then 10 sacks Cement, Cemented to bottom of collar.

(If additional description is necessary, use BACK of this sheet)

Correspondence regarding this well should be addressed to Harry Gore  
Address 400 Brown Bldg. Wichita 2, Kansas.

STATE OF Kansas, COUNTY OF Sedgwick, ss.  
R. C. Patton Drilling Contractor (employee of owner) or (owner or operator) of the above-described well, being first duly sworn on oath, says: That I have knowledge of the facts, statements, and matters herein contained and the log of the above-described well as filed and that the same are true and correct. So help me God.


(Signature) R. C. Patton  
612 Orpheum Bldg. Wichita 2, Kansas.  
(Address)

SUBSCRIBED AND SWORN to before me this 16th day of March, 19 50  
Notary Public.

My commission expires Oct 4th, 1952.

22-5133-s 9-48-10M

MAR 17 1950 3-17-50

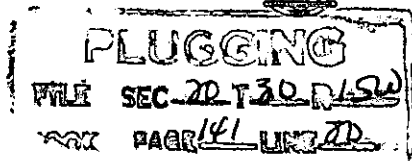

Harry Gore  
 Clawson Well #1  
 Total Depth 4460 Ft.  
 Comm. 2/11/50  
 Comp. 3/5/50  
 Contractor R. C. Patton Co.,

Located SE\*NE\*SW Sec. 20-T30S-R15W.  
 Barber County, Kansas.  
 CASING RECORD  
 8 5/8" O.D. Casing at 787Ft.  
 Cemented with 250 Sacks Cement

Red shale & Gyp	290
Shale & Shells	615
Red Sahle & Shells	630
Shale & Shells	1300
Salt & Shale	1430
Shale & Lime shells	1645
Shale & Lime	1810
Lime & Shale Bks.	1910
Lime	2165
Lime & Shale	2225
Lime & Shale Bks.	2420
Lime & Shale	2745
Shale Shells	2860
Lime & Shale	3154
Lime & Shale Bks.	3346
Broken Lime	3374
Lime & Shale	3550
Lime	3598
Lime & Shale	3770
Sand y Shale & Lime	3844
Lime & Shale	3878
Lime	4092
Shale & Lime	4131
Lime & Shale Bks.	4212
Lime & Shale	4300
Lime & Shale Bks.	4355
Lime & Shale	4401
Lime & Shale Bks.	4434
Lime & Shale	4440
Sand	4446
Shale	4460
Total Depth	4460

STATE OF Kansas COUNTY Sedgwick SS

I, the undersigned, being duly sworn, on oath state that the above statement and log is a true and correct record and log of the well drilled at the location above described.

R. C. PATTEN CO.  
 BY J. P. Hendrick

Subscribed and sworn to before me this 14th day of March 1950

George Johnston Jr.  
 Notary Public

My Commission expires 1-20-52

