

STATE OF KANSAS
STATE CORPORATION COMMISSION


WELL PLUGGING RECORD

Give All Information Completely
Make Required Affidavit
Mail or Deliver Report to:
Conservation Division
State Corporation Commission
211 No. Broadway
Wichita, Kansas

BARBER County. Sec. 20 Twp. 30 Rge. (E) 15(W)

Location as "NE/CNW&SW" or footage from lines NE NW SE
Lease Owner ALADDIN PETROLEUM CORPORATION
Lease Name GYPNUM "A" Well No. 2
Office Address 809 PETROLEUM BLDG., WICHITA, KANSAS
Character of Well (completed as Oil, Gas or Dry Hole) OIL
Date well completed SEPT. 19 50
Application for plugging filed OCT. 9 19 58
Application for plugging approved OCT. 10 19 58
Plugging commenced OCT. 27 19 58
Plugging completed NOV. 3 19 58
Reason for abandonment of well or producing formation NOT PROFITABLE

NORTH

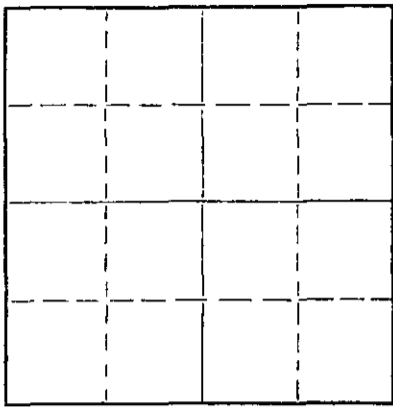

Locate well correctly on above
Section Plat

If a producing well is abandoned, date of last production DECEMBER 19 56
Was permission obtained from the Conservation Division or its agents before plugging was commenced? YES

Name of Conservation Agent who supervised plugging of this well W. L. LACKAMP, JR.
Producing formation MASSEY Depth to top 4433 Bottom 4455 Total Depth of Well 4509 Feet
Show depth and thickness of all water, oil and gas formations.

OIL, GAS OR WATER RECORDS

CASING RECORD

FORMATION	CONTENT	FROM	TO	SIZE	PUT IN	PULLED OUT
BROWN LANSING		3965'		10 3/4"	844'	NONE
MASEY ZONE		4433'				
BOTTOM OF MASSEY		4455'		7"	4502'	3189'
PENN. SAND		4502'				

Describe in detail the manner in which the well was plugged, indicating where the mud fluid was placed and the method or methods used in introducing it into the hole. If cement or other plugs were used, state the character of same and depth placed, from _____ feet to _____ feet for each plug set.

PLUG 3650'

CEMENT 3650' TO 3625'

MUD 3625' TO 265'

ROCK 265' TO 255'

CEMENT 255' TO 150'

MUD 150' TO 30'

CEMENT 30' TO BASE OF CELLAR

(If additional description is necessary, use BACK of this sheet)

Name of Plugging Contractor GLENN & SMITH PIPE PULLING CO.
Address Box 114, ELLINWOOD, KANSAS

STATE OF KANSAS, COUNTY OF SEDGWICK, ss.
J. M. JOHNSON (employee of owner) or (owner or operator) of the above-described well, being first duly sworn on oath, says: That I have knowledge of the facts, statements, and matters herein contained and the log of the above-described well as filed and that the same are true and correct. So help me God.

(Signature) [Signature]
VICE-PRES.
809 PETROLEUM BLDG., WICHITA, KANS.
(Address)

SUBSCRIBED AND SWORN to before me this 20TH day of NOVEMBER, 19 58

My commission expires 11-21-61

Faye English
Notary Public.

NOV 21 1958
CONSERVATION DIVISION
WICHITA, KANSAS
11-21-58

PLUGGING
FILE SEC 20 T 30 R 15W
BOOK PAGE 135 LINE 32

WELL LOG

Heddel and Gussman, et al National Gypsum #2 NE NW SE 20-30-15W
Barber County
Kansas

Comm. 3- 3-50
Comp. 3-29-50

Casing - 10-3/4" 848 - 100/ft
 7" 4502 - 125/ft

Red Rock	40
Red rock and shells	130
Shale	400
Shale and shells	575
Red rock and shells	606
Anhydrite	710
Shale and shells	770
Shale	850
Shale	1300
Shale and shells	1740
Broken Lime	1765
Lime	1850
Shale and lime	1910
Shale and lime	2100
Lime	2240
Shale and lime	2563
Shale and shells	2630
Shale and lime	2889
Shale and shells	2980
Shale and lime	3085
Shale and shells	3205
Lime and shale	3565
Lime 3762	3762
Lime and shale	4000
Lime	4455
Lime and shale	4477
Lime	4485
Lime and shale	4502
Sand	4509 F.D.

STATE CORPORATION C
OCT 10 1950
CONSERVATION COMMISSION
Wichita, Kansas

STATE OF KANSAS }
COUNTY OF SEDGWICK } ss:

PLUGGING
FILE SEC 20 T. 30 R. 15W
BOOK PAGE 135 LINE 32

L. C. Hay, of lawful age being first duly sworn deposes and states that the above formations and depths are true and correct as taken from the daily drilling log of the National Gypsum No. 2 Well in the NE NW SE 20-30-15W, Barber County, Kansas.

L. C. Hay
Notary Public

Subscribed and sworn to before me this 30th day of March, 1950.
My commission expires Nov. 3, 1952