

STATE OF KANSAS  
STATE CORPORATION COMMISSION


WELL PLUGGING RECORD

OR  
FORMATION PLUGGING RECORD

Strike out upper line  
when reporting plug-  
ging off formations.

Give All Information Completely  
Make Required Affidavit  
Mail or Deliver Report to:  
Conservation Division  
State Corporation Commission  
800 Bittling Building  
Wichita, Kansas

NORTH

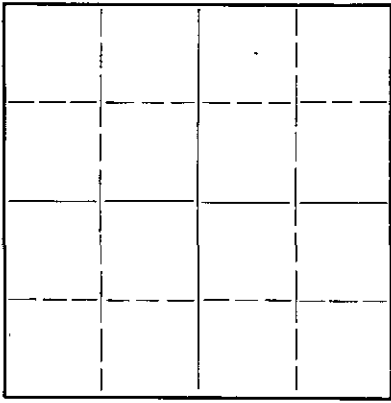

Locate well correctly on above  
Section Plat

Barber County, Sec. 20 Twp. 30 Rge. (E) 15 (W)  
Location as "NE $\frac{1}{4}$ NW $\frac{1}{4}$ SW $\frac{1}{4}$ " or footage from lines 330' FWL 280' FSL of SE $\frac{1}{4}$   
Lease Owner The Superior Oil Company  
Lease Name M. L. Tucker Well No. 1  
Office Address 407 First National Bank Building, Wichita 2, Ks.  
Character of Well (completed as Oil, Gas or Dry Hole) Dry Hole  
Date well completed 6-22 1943  
Application for plugging filed 6-22 1943  
Application for plugging approved 6-22 1943  
Plugging commenced 6-22 1943  
Plugging completed 6-23 1943  
Reason for abandonment of well or producing formation Dry Hole  
If a producing well is abandoned, date of last production 19  
Was permission obtained from the Conservation Division or its agents before plugging was com-  
menced? Yes

Name of Conservation Agent who supervised plugging of this well  
Producing formation Depth to top Bottom Total Depth of Well 4770 Feet  
Show depth and thickness of all water, oil and gas formations.

OIL, GAS OR WATER RECORDS

CASING RECORD

Formation	Content	From	To	Size	Put In	Pulled Out
Rotary hole.	No oil or gas shows					



Describe in detail the manner in which the well was plugged, indicating where the mud fluid was placed and the method or methods used in introducing it into the hold. If cement or other plugs were used, state the character of same and depth placed, from feet to feet for each plug set.

Surface pipe set 309'

Plug 310' to 280'

Five sacks in top of surface casing

Filled hole with 15 pound mud

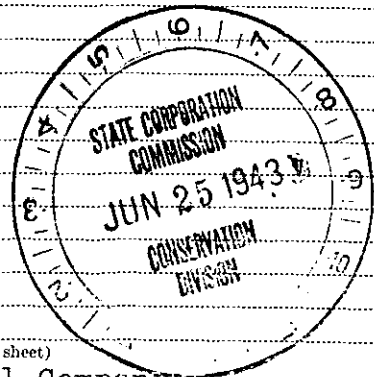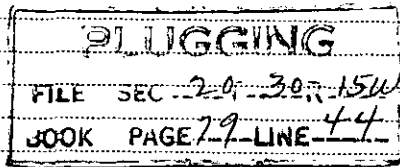

(If additional description is necessary, use BACK of this sheet)

Correspondence regarding this well should be addressed to The Superior Oil Company  
Address 407 First National Bank Building, Wichita 2, Kansas

STATE OF Kansas COUNTY OF Sedgwick, ss.  
J. A. Mull (employee of owner) or (owner or operator) of the above-described well,  
being first duly sworn on oath, says: That I have knowledge of the facts, statements, and matters herein contained and the log of the above-described well as filed and that the same are true and correct. So help me God.

(Signature) J. A. Mull

407 1st Natl. (Address)

SUBSCRIBED AND SWORN to before me this 24th day of June, 1943

My commission expires May 5, 1945  
Mildred J. Jaeger Notary Public.

THE SUPERIOR OIL COMPANY OF CALIFORNIA

Tucker No. 1

Sec. 20-30-15W  
SW SW SE

Total Depth-4770  
Comm. 5-12-43 Comp 6-23-43

County--Barber

CASING

10 3/4" 309'

Elevation--1741

Production--Dry

Figures Indicate Bottom of Formations

red bed & shale	315		
shale & shells	490		
red bed & shale	840	chert & lime	4597
lime & shale	1355	shale & chert	4609
shale & shells	1620	shale & lime	4618
sandy lime & shale	1840	shale & lime	4718
lime with sand		lime	4770
strks.	1895		
lime	2015		
lime & shale	2220	TOPS	
lime	2270	Florence Flint	2270
lime & shale	2300	Lansing	3876
shale & shells	2425	Viola	4474
lime & shale	2590	Simpson	4559
shale & shells	2710	Arbuckle	4718
lime	2725		
cherty lime	2727	Total Depth 4770	
shale & shells	2860	No shows.	
shale	2870		
lime & shale	2945		
shale	3000	D & A	
shale & shells	3100		
lime	3310		
broken lime	3390		
lime	3590		
lime with shale			
strks.	3650		
lime	3685		
shale & lime	3740		
lime with sand			
strks.	3790		
lime	3840		
sandy lime & shale	3860		
lime	4043		
lime & chert	4070		
lime	4431		
sand stone & shale	4467		
lime	4474		
lime with chert			
strks.	4490		
lime & chert	4533		
lime with chert			
strks.	4549		

20 30 15W  
79 44

I hereby certify that this is a true and accurate log  
of the Tucker No. 1, SW SW SE, 20-30-15W, Barber County, Kansas

*J. A. Mull*  
J. A. Mull  
District Geologist

