


WELL PLUGGING RECORD

Give All Information Completely
Make Required Affidavit
Mail or Deliver Report to:
Conservation Division
State Corporation Commission
211 No. Broadway
Wichita, Kansas

NORTH

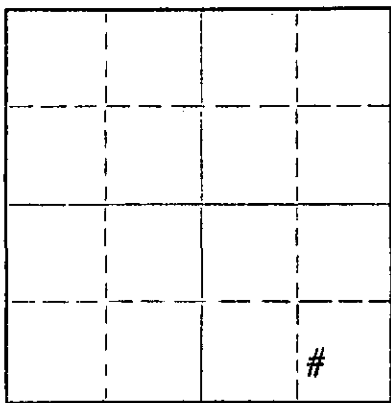

Locate well correctly on above
Section Plat

Barber County. Sec. 16 Twp. 30 Rge. 15 (E) W (W)
Location as "NE/CNWxSWx" or footage from lines SE SE SW
Lease Owner Petroleum Management Inc.
Lease Name Moffett Well No. 1
Office Address 1515 Wichita Plaza Wichita, Ka.
Character of Well (completed as Oil, Gas or Dry Hole) Dry Hole
Date well completed _____ 19____
Application for plugging filed Jan 22, 1964
Application for plugging approved Jan 27, 1964
Plugging commenced Jan 24, 1964
Plugging completed Jan 27, 1964
Reason for abandonment of well or producing formation Dry hole

If a producing well is abandoned, date of last production _____ 19____
Was permission obtained from the Conservation Division or its agents before plugging was commenced? Yes

Name of Conservation Agent who supervised plugging of this well Archie Elving
Producing formation _____ Depth to top _____ Bottom _____ Total Depth of Well 4610 Feet
Show depth and thickness of all water, oil and gas formations.

OIL, GAS OR WATER RECORDS

CASING RECORD

FORMATION	CONTENT	FROM	TO	SIZE	PUT IN	PULLED OUT
				8 5/8	321'	None
				4 1/2	4610'	3974'

Describe in detail the manner in which the well was plugged, indicating where the mud fluid was placed and the method or methods used in introducing it into the hole. If cement or other plugs were used, state the character of same and depth placed, from _____ feet to _____ feet for each plug set.

Plugged back with sand from 4246' to 4220'. Mixed and dumped 4 sx. of cement from 4220' to 4178'. Pulled casing. Mudded hole to 290'. Set 10' rock bridge from 290' to 280'. Mixed and dumped 25 sx. of cement from 280' to 205'. Mudded hole from 205' to 40'. Set 10' rock bridge from 40' to 30'. Mixed and dumped 10 sx. of cement from 30' to base of the cellar.

RECEIVED
STATE CORPORATION COMMISSION

MAY 4 1964 5-4-64

CONSERVATION DIVISION
Wichita, Kansas

(If additional description is necessary, use BACK of this sheet)

Name of Plugging Contractor Ace Pipe Pulling Co.
Address Box 304 Great Bend, Ka.

STATE OF KANSAS, COUNTY OF SEDGWICK, ss.
H. G. Unruh, Petroleum Management, Inc. (employee of owner) or (owner or operator) of the above-described well, being first duly sworn on oath, says: That I have knowledge of the facts, statements, and matters herein contained and the log of the above-described well as filed and that the same are true and correct. So help me God.

(Signature) H. G. Unruh
1515 Wichita Plaza, Wichita, Kansas
(Address)

SUBSCRIBED AND SWORN TO before me this 1st day of May, 1964

My commission expires August 14, 1965

Barbara A. Brown
Notary Public.

Copy of Logue

Moffett # 1

SE SE SW Sec. 16-30-15w
Barber Co, Kansas

Elevation G L 1927

According to the geologist report the formation tops were determined as follows:

Heebner	3846'
Toronto	3870'
Douglas	3886'
K C	4036'
Marmaton	4408'

R T D 4610'

RECEIVED
STATE CORPORATION COMMISSION

JAN 23 1904

CONSERVATION DIVISION
Wichita, Kansas