

TYPE

AFFIDAVIT OF COMPLETION FORM

ACO-1 WELL HISTORY

Compt. _____

SIDE ONE

Two (2) copies of this form shall be filed with the Kansas Corporation Commission, 200 Colorado Derby Building, Wichita, Kansas 67202, within thirty (30) days after the completion of a well, regardless of how the well was completed.

F Attach separate letter of request if the information is to be held confidential. If confidential, only file one copy. Information on Side One will be of public record and Side Two will then be held confidential.

Applications must be made on dual completion, commingling, salt water disposal, injection and temporarily abandoned wells.

C Attach one copy only wireline logs (i.e. electrical log, sonic log, gamma ray neutron log, etc.). (Rules 82-2-105 & 82-2-125) KCC# (316) 263-3238.

LICENSE # 5002 EXPIRATION DATE June 30, 1983

OPERATOR George R. Jones API NO. 15-007-21,549-00-00

ADDRESS 125 N. Market, Suite 1210 COUNTY Barber

Wichita, KS 67202 FIELD _____

** CONTACT PERSON George R. Jones PROD. FORMATION _____
PHONE 316-262-5503

PURCHASER _____ LEASE Pike

ADDRESS _____ WELL NO. 2

DRILLING Red Tiger Drilling Company WELL LOCATION 600' N. C NW SE

CONTRACTOR 1720 Kansas State Bank Building 2580 Ft. from S Line and

ADDRESS Wichita, KS 67202 1980 Ft. from E Line of

these (Qtr.) SEC 15 TWP 31 RGE 12W.

PLUGGING Halliburton Services WELL PLAT _____ (Office Use Only)

CONTRACTOR _____

ADDRESS Colorado Derby Building KCC
Wichita, KS 67202 KGS


TOTAL DEPTH 4400' PBTD _____ SWD/REP _____

SPUD DATE 1/4/83 DATE COMPLETED 1/11/83 PLG. _____

ELEV: GR 1649' DF _____ KB _____

DRILLED WITH (CABLE) - ROTARY (AIR) TOOLS.

DOCKET NO. OF DISPOSAL OR REPRESSURING WELL BEING USED TO DISPOSE OF WATER FROM THIS LEASE _____

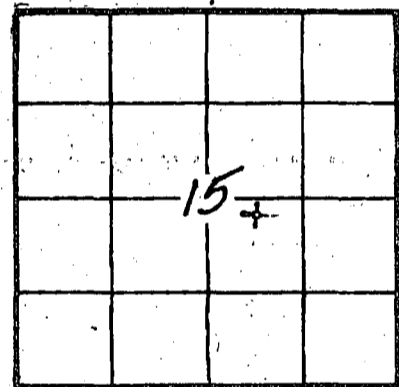

Amount of surface pipe set and cemented 8 jts DV Tool Used? _____

THIS AFFIDAVIT APPLIES TO: (Circle ONE) - Oil, Gas, Shut-in Gas, Dry Disposal, Injection, Temporarily Abandoned, OWWO. Other _____

ALL REQUIREMENTS OF THE STATUTES, RULES AND REGULATIONS PROMULGATED TO REGULATE THE OIL AND GAS INDUSTRY HAVE BEEN FULLY COMPLIED WITH.

A F F I D A V I T


George R. Jones, being of lawful age, hereby certifies that:

I am the Affiant, and I am familiar with the contents of the foregoing Affidavit. The statements and allegations contained therein are true and correct.

George R. Jones
(Name)

SUBSCRIBED AND SWORN TO BEFORE ME this 13th day of January, 19 83.

19 83.

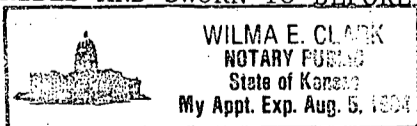

Wilma E. Clark
(NOTARY PUBLIC)

MY COMMISSION EXPIRES: August 5, 1984

RECEIVED
STATE CORPORATION COMMISSION

** The person who can be reached by phone regarding any questions concerning this information.

JAN 14 1983
CONSERVATION DIVISION
Wichita, Kansas

