

15-007-21161-0000

STATE OF KANSAS  
STATE CORPORATION COMMISSION

WELL PLUGGING RECORD

Give All Information Completely  
Make Required Affidavit  
Mail or Deliver Report to  
Conservation Division  
State Corporation Comm.  
245 North Water  
Wichita, KS 67202

Barber County, Sec. 18 Twp. 32S Rge. 11W E/W  
Location as "NE/CNW $\frac{1}{4}$ SW $\frac{1}{4}$ " or footage from lines  
C W/2 NE SE

Lease Owner Lee Phillips Oil Company

Lease Name Platt Well No. 1

Office Address 125 N. Market, Suite 1532, Wichita, KS 67202

Character of Well (Completed as Oil, Gas or Dry Hole)  
Dry Hole

Date Well completed April 27, 1981

Application for plugging filed April 27, 1981

Application for plugging approved April 27, 1981

Plugging commenced April 27, 1981

Plugging completed April 27, 1981

Reason for abandonment of well or producing formation  
Dry Hole


If a producing well is abandoned, date of last production  
19

Was permission obtained from the Conservation Division or  
its agents before plugging was commenced? Yes

Name of Conservation Agent who supervised plugging of this well Wm. T. Owen

Producing formation \_\_\_\_\_ Depth to top \_\_\_\_\_ Bottom \_\_\_\_\_ Total Depth of Well 3750'

Show depth and thickness of all water, oil and gas formations.

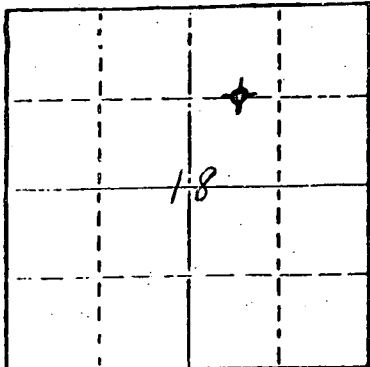

Locate well correctly on above  
Section Plat

OIL, GAS OR WATER RECORDS

CASING RECORD

FORMATION	CONTENT	FROM	TO	SIZE	PUT IN	PULLED OUT
		0'	251'	8-5/8"	244.16'	None

Describe in detail the manner in which the well was plugged, indicating where the mud fluid was placed and the method or methods used in introducing it into the hold. If cement or other plugs were used, state the character of same and depth placed, from \_\_\_\_\_ feet to \_\_\_\_\_ feet for each plug set.

Plugged with 50 sacks cement at 270';  
10 sacks cement at 40'; and 10 sacks cement  
in rat hole.


(If additional description is necessary, use BACK of this sheet)

Name of Plugging Contractor Allied Cementing Co.

STATE OF KANSAS COUNTY OF SEDGWICK, ss.  
John D. Knightley Agent (employee of owner) or (owner or operator)  
of the above-described well, being first duly sworn on oath, says: That I have knowledge of  
the facts, statements, and matters herein contained and the log of the above-described well  
as filed and that the same are true and correct. So help me God.

(Signature) [Signature]  
221 S. Broadway, Wichita, Kansas 67202  
(Address)

SUBSCRIBED AND SWORN TO before me this 6th day of May, 1981

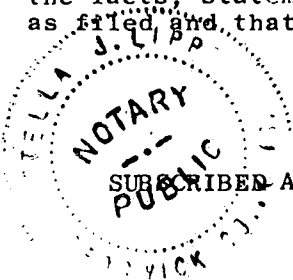

RECEIVED  
Stella J. Lippert  
Notary Public.

My commission expires March 12, 1983

MAY 7 1981  
5-7-81  
CONSERVATION DIVISION  
Wichita, Kansas

Lee Phillips Oil Company -  
125 N. Market, Suite 1532  
Wichita, Kansas 67202

Platt #1  
C W/2 NE SE Section 18-32S-11W  
Barber County, Kansas

Contractor: D. R. Lauck Oil Company, Inc.  
221 S. Broadway, Suite 400  
Wichita, Kansas 67202

Commenced: April 21, 1981  
Completed: April 27, 1981

Drillers Log

Sand, Clay, Gyp	254
Red Bed & Shale	815
Shale	1560
Lime & Shale	1795
Shale	2585
Shale & Lime	3440
Lime & Shale	3750 RTD

RECEIVED  
STATE CORPORATION COMMISSION  
MAY 7 1981  
5-7-81  
CONSERVATION DIVISION  
Wichita, Kansas