

STATE OF KANSAS  
STATE CORPORATION COMMISSION

Form CP-4

*Dup*


WELL PLUGGING RECORD

Give All Information Completely  
Make Required Affidavit  
Mail or Deliver Report to:  
Conservation Division  
State Corporation Commission  
211 No. Broadway  
Wichita, Kansas

BARBER County. Sec. 34 Twp. 34 Rge. 13W (X) (W)

Location as "NE/CNWSW" or footage from lines NE NW SE  
Lease Owner PETROLEUM, INC.  
Lease Name ROBERTS "B" Well No. 1  
Office Address ROUTE 2, GREAT BEND, KANSAS  
Character of Well (completed as Oil, Gas or Dry Hole) GAS  
Date well completed AUGUST 30 1956  
Application for plugging filed MAY 21 1963  
Application for plugging approved MAY 23 1963  
Plugging commenced MAY 31 1963  
Plugging completed JUNE 5 1963  
Reason for abandonment of well or producing formation DEPLETION OF  
PRODUCIBLE FORMATIONS  
If a producing well is abandoned, date of last production APRIL 12, 1963  
Was permission obtained from the Conservation Division or its agents before plugging was commenced? YES

NORTH

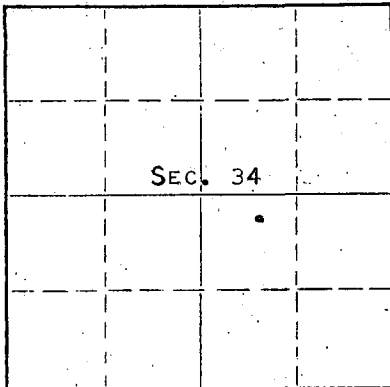

Locate well correctly on above  
Section Plat

Name of Conservation Agent who supervised plugging of this well ARCHIE ELVING  
Producing formation ELGIN Depth to top 3652 Bottom -- Total Depth of Well 4881 Feet

Show depth and thickness of all water, oil and gas formations.

OIL, GAS OR WATER RECORDS

CASING RECORD

FORMATION	CONTENT	FROM	TO	SIZE	PUT IN	PULLED OUT
ELGIN	SMALL AMOUNT OF GAS & WATER	3661	3665	8-5/8"	304'	NONE
				5-1/2"	3900'	3283'

Describe in detail the manner in which the well was plugged, indicating where the mud fluid was placed and the method or methods used in introducing it into the hole. If cement or other plugs were used, state the character of same and depth placed, from \_\_\_\_\_ feet to \_\_\_\_\_ feet for each plug set.

PLUGGED BACK TOTAL DEPTH: 3790'

FILLED HOLE WITH CRUSHED ROCK FROM 3790' TO 3660'. MIXED AND DUMPED 5 SACKS CEMENT THROUGH DUMP BAILER. BAILED FLUID TO 225' AND SET 10' SOLID ROCK BRIDGE. MIXED AND DUMPED 20 SACKS CEMENT ONTO ROCK BRIDGE. MUDDED UP HOLE TO 40' AND SET 10' SOLID ROCK BRIDGE. MIXED AND DUMPED 10 SACKS CEMENT TO BASE OF WELL CELLAR.

RECEIVED  
STATE CORPORATION COMMISSION

JUN 12 1963

CONSERVATION DIVISION  
Wichita, Kansas

(If additional description is necessary, use BACK of this sheet)

Name of Plugging Contractor SOUTHWEST CASING PULLING Co., Inc.  
Address Box 364, GREAT BEND, KANSAS

STATE OF KANSAS, COUNTY OF BARTON, ss.  
DON SEARLE (employee of owner) or (owner/contractor) of the above-described

well, being first duly sworn on oath, says: That I have knowledge of the facts, statements, and matters herein contained and the log of the above-described well as filed and that the same are true and correct. So help me God.

(Signature) DON SEARLE, DIST. PROD. SUPT.  
ROUTE 2, GREAT BEND, KANSAS (Address)

SUBSCRIBED AND SWORN TO before me this 10TH day of JUNE, 1963

My commission expires APRIL 14, 1967

Arthur J. Miles  
Notary Public.

# WELL LOG

COMPANY PETROLEUM, INCORPORATED

SEC. 34 T. 34S R. 13W

FARM Roberts 'B' NO. 1


LOC. NE, NW, SE

TOTAL DEPTH 4881'

COUNTY Barber Co., Kansas

COMM. August 3, 1956 COMP. August 19, 1956

CONTRACTOR GARVEY DRILLING COMPANY

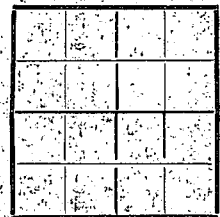

CASING 8 5/8" @ 304' W/225 sax.  
5 1/2" @ 3900' W/100 sax.

ELEVATION 1516' DF

PRODUCTION Elgin

FIGURES INDICATE BOTTOM OF FORMATIONS:

305	Red bed & sand	Elgin	3651'
700	Red bed & shells	Heebner	3900'
1310	Shale & shells	Douglas	3906'
3395	Shale & lime	Lansing	4031'
3507	Shale	K. C.	4383'
3765	Shale & lime		
3899	Sand & shale		
4114	Lime & shale		
4159	Lime		
4288	Lime & shale		
4326	Lime		
4766	Lime & shale		
4820	Lime		
4881	Lime & shale		
4881	T. D.		

**RECEIVED**  
STATE CORPORATION COMMISSION

JUN 12 1963

CONSERVATION DIVISION  
Wichita, Kansas

State of KANSAS

County of BARTON

} ss:

I, Verne A. Morris of Garvey Drilling Company

upon oath state that the above and foregoing is a true and correct copy of the log of the #1 Roberts 'B' well

Verne A. Morris

Subscribed and sworn to before me this 25th day of August 19 56

My Commission Expires: July 11, 1960

Jed A. Brown  
NOTARY PUBLIC