

WELL PLUGGING RECORD

Give All Information Completely
Make Required Affidavit
Mail or Deliver Report to:
Conservation Division
State Corporation Commission
211 No. Broadway
Wichita, Kansas

BARBER County. Sec. 34 Twp. 34s Rge. (E) 13 (W)

Location as "NE/CNW&SW" or footage from lines NE SE SE NW

Lease Owner PETROLEUM, INC.,

Lease Name ELWOOD WASTE WATER DISPOSAL Well No. 1

Office Address ROUTE 2, GREAT BEND, KANSAS

Character of Well (completed as Oil, Gas or Dry Hole) WASTE WATER DISPOSAL

Date well completed MAY 4 19 57

Application for plugging filed SEPT. 30 19 64

Application for plugging approved OCTOBER 1 19 64


Plugging commenced OCTOBER 2 19 64

Plugging completed OCTOBER 4 19 64

Reason for abandonment of well or producing formation DISPOSAL FACILITIES
NO LONGER REQUIRED

If a producing well is abandoned, date of last production - 19

Was permission obtained from the Conservation Division or its agents before plugging was commenced? YES

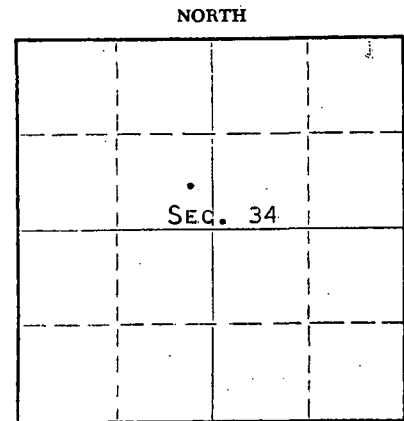

Locate well correctly on above Section Plat

Name of Conservation Agent who supervised plugging of this well ARCHIE ELVING, BOX 248, PRATT, KANSAS

Producing formation LOWER ELGIN Depth to top 3696 Bottom 3830 Total Depth of Well 3830 Feet

Show depth and thickness of all water, oil and gas formations.

OIL, GAS OR WATER RECORDS

CASING RECORD

FORMATION	CONTENT	FROM	TO	SIZE	PUT IN	PULLED OUT
LOWER ELGIN	WATER	3696	3830	8-5/8"	289'	NONE
				4-1/2"	3696'	3276'

Describe in detail the manner in which the well was plugged, indicating where the mud fluid was placed and the method or methods used in introducing it into the hole. If cement or other plugs were used, state the character of same and depth placed, from feet to feet for each plug set.

PLUGGED BOTTOM OF HOLE WITH CRUSHED ROCK FROM 3830' TO 3680', FOLLOWED BY 3 SACKS CEMENT THRU DUMP BAILER. MUDDED UP WITH HEAVY MUD TO 250' AND A 10' BRIDGE BUILT W/ SOLID ROCK. MIXED AND RAN 20 SACKS CEMENT WITH DUMP BAILER. MUDDED UP WITH HEAVY MUD TO 40', FOLLOWED BY A 10' BRIDGE BUILT OF SOLID ROCK. MIXED AND DUMPED 10 SACKS CEMENT TO BASE OF WELL CELLAR.

RECEIVED
STATE CORPORATION COMMISSION

OCT 9 - 1964

CONSERVATION DIVISION
Wichita, Kansas

Name of Plugging Contractor ^(If additional description is necessary, use BACK of this sheet) SOUTHWEST CASING PULLING CO., INC.
Address BOX 364, GREAT BEND, KANSAS

STATE OF KANSAS, COUNTY OF BARTON, ss.

MONTE CHADD (employee of owner) or (~~owner or operator~~) of the above-described well, being first duly sworn on oath, says: That I have knowledge of the facts, statements, and matters herein contained and the log of the above-described well as filed and that the same are true and correct. So help me God.

(Signature) MONTE CHADD DIST PROD SUPT.

ROUTE #2, GREAT BEND, KANSAS
(Address)

SUBSCRIBED AND SWORN TO before me this 18TH day of OCTOBER, 19 64.

My commission expires APRIL 14, 1967

Charles J. Wile
Notary Public.

WELL LOG

COMPANY **PETROLEUM, INCORPORATED**

SEC. **34** T. **34S** R. **13W**

FARM **ELWOOD 'WWD'** NO. **1**

LOC. **NE, SE, SW**


TOTAL DEPTH **3830'**

COUNTY **Barber Co., Kansas**

COMM. **April 19, 1957**

COMP. **April 28, 1957**

CONTRACTOR **GARVEY DRILLING COMPANY**

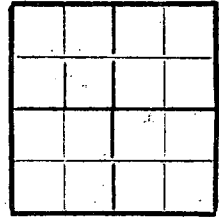

CASING **8 5/8" @ 289' w/175 sax.**
4 1/2" @ 369 1/2' w/60 sax.

ELEVATION **1507' DF**

PRODUCTION **Waste Water Disposal**

FIGURES INDICATE BOTTOM OF FORMATIONS

1380	Shale & red bed
1795	Shale & shells
1900	Lime & shale
2010	Lime
2240	Lime & shale
2295	Sand & shale
2860	Lime & shale
2957	Shale
3180	Shale & lime
3265	Shale
3632	Lime & shale
3830	Sand & shale
3830	T. D.

RECEIVED
STATE CORPORATION COMMISSION

OCT 9 - 1964

CONSERVATION DIVISION
Wichita, Kansas

State of **KANSAS** }
County of **BARTON** } SS:

I, **Verne A. Morris** of **Garvey Drilling Co.**

upon oath state that the above and foregoing is a true and correct copy of the log of the **#1 Elwood 'WWD'** well

Subscribed and sworn to before me this **28th** day of **May** 19 **57**

My Commission Expires: **July 11, 1960**

Verne A. Morris
[Signature]
NOTARY PUBLIC