


STATE OF KANSAS
STATE CORPORATION COMMISSION

WELL PLUGGING RECORD

Give All Information Completely
Make Required Affidavit
Mail or Deliver Report to:
Conservation Division
State Corporation Commission
211 No. Broadway
Wichita, Kansas

NORTH

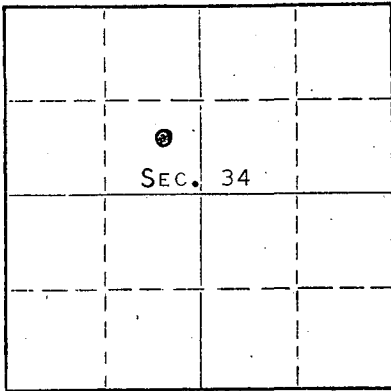

Locate well correctly on above
Section Plat

BARBER County. Sec. 34 Twp. 34 Rge. 13W (X) (W)
Location as "NE/CNW/SW" or footage from lines C E/2-SE-NW
Lease Owner PETROLEUM, INC.,
Lease Name HOUSTON C Well No. 2
Office Address R. R. #2 GREAT BEND, KANSAS
Character of Well (completed as Oil, Gas or Dry Hole) GAS WELL
Date well completed 12-14-62 19 57
Application for plugging filed NOVEMBER 14 19 62
Application for plugging approved NOVEMBER 16 19 62
Plugging commenced NOVEMBER 27 19 62
Plugging completed NOVEMBER 29 19 62
Reason for abandonment of well or producing formation DEPLETION OF ALL PRODUCABLE FORMATION
If a producing well is abandoned, date of last production NOVEMBER 2 19 62
Was permission obtained from the Conservation Division or its agents before plugging was commenced? YES

Name of Conservation Agent who supervised plugging of this well HERMAN JUSTUS
Producing formation ELGIN SAND Depth to top 3636 Bottom 3648 Total Depth of Well 3648 Feet
Show depth and thickness of all water, oil and gas formations.

OIL, GAS OR WATER RECORDS

CASING RECORD

FORMATION	CONTENT	FROM	TO	SIZE	PUT IN	PULLED OUT
ELGIN SAND	WATER AND	3643	3646	8-5/8"	310'	NONE
	SMALL AMOUNT			4-1/2"	3647'	3155'
	OF GAS					

Describe in detail the manner in which the well was plugged, indicating where the mud fluid was placed and the method or methods used in introducing it into the hole. If cement or other plugs were used, state the character of same and depth placed, from _____ feet to _____ feet for each plug set.

PLUGGED OFF BOTTOM OF HOLE FROM 3646 TO 3610 WITH CRUSHED ROCK AND 3 SACKS CEMENT. MUDDED UP WITH HEAVY MUD TO 300' AND BUILT SOLID ROCK BRIDGE. PLACED 20 SACKS CEMENT ON TOP OF ROCK BRIDGE. MUDDED UP WITH HEAVY MUD TO 40' & BUILT SOLID ROCK BRIDGE. PLACED 10 SACKS CEMENT ON TOP OF SOLID ROCK BRIDGE TO BASE OF WELL CELLAR.

RECEIVED
STATE CORPORATION COMMISSION

DEC 4 1962

CONSERVATION DIVISION
Wichita, Kansas

(If additional description is necessary, use BACK of this sheet)
Name of Plugging Contractor SOUTHWEST CASING PULLING CO., INC.
Address Box 364, GREAT BEND, KANSAS

STATE OF KANSAS, COUNTY OF BARTON, ss.

DON SEARLE

(employee of owner) or (owner) of the above-described

well, being first duly sworn on oath, says: That I have knowledge of the facts, statements, and matters herein contained and the log of the above-described well as filed and that the same are true and correct. So help me God.

(Signature)

Don Searle
DON SEARLE, DIST. PROD. SUPT.
ROUTE #2, GREAT BEND, KANSAS

(Address)

SUBSCRIBED AND SWORN TO before me this 30TH day of NOVEMBER, 19 62.

My commission expires

APRIL 14, 1963.

Notary Public.



WELL LOG

COMPANY PETROLEUM, INCORPORATED

SEC. 34 T. 34S R. 13W

FARM HOUSTON 'C' NO. 2


LOC. C/E/2 SE, NW

TOTAL DEPTH 3648'

COUNTY Barber Co., Kansas

COMM. December 6, 1956 COMP. December 15, 1956

CONTRACTOR GARVEY DRILLING COMPANY

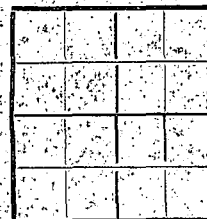

CASING 8 5/8" @ 310' W/175 sax.
4 1/2" @ 3647' W/75 sax.

ELEVATION 1511' DF

PRODUCTION Mississippi

FIGURES INDICATE BOTTOM OF FORMATIONS

310	Surface clay & sand
1315	Red bed, shale & sand
1700	Shale & shells
2160	Lime & shale
2478	Lime
3175	Lime & shale
3345	Lime
3630	Lime & shale
3648	Sand & lime
3648	T. D.

RECEIVED
STATE CORPORATION COMMISSION

DEC 4 1962

CONSERVATION DIVISION
Wichita, Kansas

State of KANSAS }
County of BARTON } ss:

I, Verne A. Morris of Garvey Drilling Co.

upon oath state that the above and foregoing is a true and correct copy of the log of the #2 Houston 'C' well

Verne A. Morris

Subscribed and sworn to before me this 15th day of February 19 57

My Commission Expires: July 11, 1960

Red Brown
NOTARY PUBLIC