


STATE OF KANSAS
STATE CORPORATION COMMISSION

WELL PLUGGING RECORD

Give All Information Completely
Make Required Affidavit
Mail or Deliver Report to
Conservation Division
State Corporation Comm.
245 North Water
Wichita, KS 67202

Barber County, Sec. 2 Twp. 31S Rge. 12 ~~NE~~/W
Location as "NE/CNW/SW" or footage from lines
NE NE NE

Lease Owner George R. Jones
Lease Name Mott "B" Well No. 1
Office Address Suite 1310, 125 No. Market, Wichita, KS 67202
Character of Well (Completed as Oil, Gas or Dry Hole)
dry hole

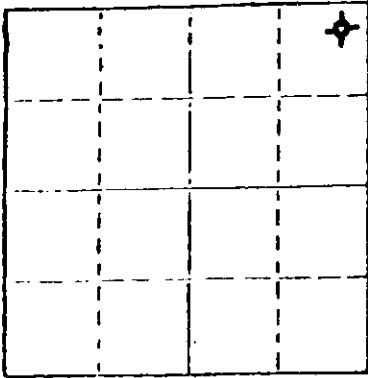

Locate well correctly on above
Section Plat

Date Well completed May 18, 1980 19
Application for plugging filed verbal application 19
Application for plugging approved verbal approval 19
Plugging commenced May 18, 1980 19
Plugging completed May 18, 1980 19
Reason for abandonment of well or producing formation
dry hole

If a producing well is abandoned, date of last production
19

Was permission obtained from the Conservation Division or
its agents before plugging was commenced? Yes

Name of Conservation Agent who supervised plugging of this well Wm. T. Owen
Producing formation Depth to top Bottom Total Depth of Well
Show depth and thickness of all water, oil and gas formations.

OIL, GAS OR WATER RECORDS

CASING RECORD

FORMATION	CONTENT	FROM	TO	SIZE	PUT IN	PULLED OUT
				7 jts 20# 8-5/8"	sfc cas;	set at 287';
				cemented with 265	sacks Common,	2% gel, 3%
				c.c. PD 12 p.m.	5/10/80	

Describe in detail the manner in which the well was plugged, indicating where the mud fluid
was placed and the method or methods used in introducing it into the hold. If cement or other
plugs were used, state the character of same and depth placed, from _____ feet to
_____ feet for each plug set.

first plug @ 540' w/40 sacks;
second plug @ 270' w/40 sacks;
third plug @ 40' w/10 sacks;
5 sacks in rathole

RECEIVED
STATE CORPORATION COMMISSION

AUG 19 1980

CONSERVATION DIVISION
Wichita, Kansas

(If additional description is necessary, use BACK of this sheet)

Name of Plugging Contractor Halliburton Services


STATE OF KANSAS COUNTY OF SEDGWICK, ss.
George R. Jones (employee of owner) or (owner or operator)
of the above-described well, being first duly sworn on oath, says: That I have knowledge of
the facts, statements, and matters herein contained and the log of the above-described well
as filed and that the same are true and correct. So help me God.

(Signature) [Signature]
Suite 1310, 125 No. Market, Wichita, KS 67202
(Address)

SUBSCRIBED AND SWORN TO before me this 3rd day of June, 19 80

[Signature]
Wilma E. Clark Notary Public.

My commission expires August 5, 1980

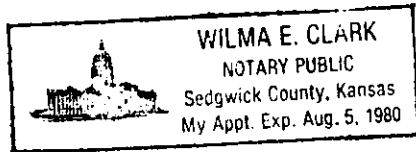

GABBERT-JONES, INC.
830 Sutton Place
WICHITA, KANSAS 67202

DRILLERS' WELL LOG

MOTT #1-B
NE NE NE Sec. 2031S-12W
Barber County, Kansas

OPERATOR: GEORGE R. JONES

Commenced: 5-10-80

Completed: 5-19-80

Depth -

From	To	Formation	Remarks
0	1504	Redbed	Ran 7 joints of 20# 8 5/8" csg L D @ 287' cemented w/265 Sx. common 2% Gel - 3% CC P.D. @ 12:00 PM 5/10/80
1500	2245	Shale	
2245	2485	Lime-Shale	
2485	2925	Shale-Lime	
2925	3155	Lime-Shale	
3155	3540	Shale-Lime	
3540	3760	Lime-Shale	
3760	4310	Lime	

4310 Total Depth

D & A

RECEIVED
STATE CORPORATION COMMISSION

AUG 19 1980

CONSERVATION DIVISION
Wichita, Kansas

STATE OF KANSAS

COUNTY OF SEDGWICK

} SS

I, the undersigned, being duly sworn on oath, state that the above Drillers' Well log is true and correct to the best of my knowledge and belief and according to the records of this office.

GABBERT-JONES, INC.

James S. Sutton, II
James S. Sutton, II

Subscribed and sworn to before me this 21st day of May, 1980.

Paul Leroy Costa

My Commission expires October 20, 1980.

