

STATE OF KANSAS
STATE CORPORATION COMMISSION

WELL PLUGGING RECORD

Give All Information Completely
Make Required Affidavit
Mail or Deliver Report to:
Conservation Division
State Corporation Commission
800 Bitting Building
Wichita, Kansas

Barber County. Sec. 3 Twp. 31S Rge. 12W (~~12E~~)

Location as "NE/CNW/SW" or footage from lines NW NW NE

Lease Owner W. C. DOENGES

Lease Name HAAS Well No. 1

Office Address 320 Union Natl Bldg., Wichita

Character of Well (completed as Oil, Gas or Dry Hole) Dry hole

Date well completed April 21, 19 53

Application for plugging filed April 23 19 53

Application for plugging approved April 24 19 53


Plugging commenced _____ 19 _____

Plugging completed _____ 19 _____

Reason for abandonment of well or producing formation Dry hole

If a producing well is abandoned, date of last production _____ 19 _____

Was permission obtained from the Conservation Division or its agents before plugging was commenced? Yes

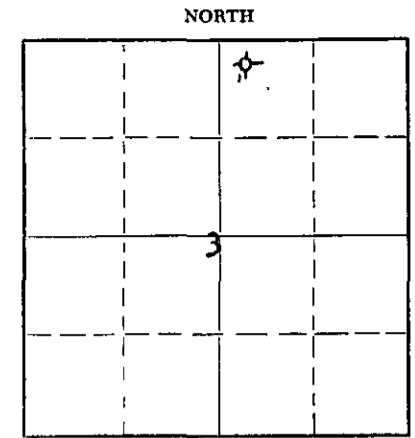

Locate well correctly on above Section Plat

Name of Conservation Agent who supervised plugging of this well M. A. Rives

Producing formation _____ Depth to top _____ Bottom _____ Total Depth of Well 4732 Feet

Show depth and thickness of all water, oil and gas formations.

OIL, GAS OR WATER RECORDS

CASING RECORD

FORMATION	CONTENT	FROM	TO	SIZE	PUT IN	PULLED OUT

Describe in detail the manner in which the well was plugged, indicating where the mud fluid was placed and the method or methods used in introducing it into the hole. If cement or other plugs were used, state the character of same and depth placed, from _____ feet to _____ feet for each plug set.

Filled hole with mud laden fluid.
Pushed bottom plug down 300'.
Pushed top plug to 30' and cemented with 10 sack cement.

(If additional description is necessary, use BACK of this sheet)

Name of Plugging Contractor Wood Coppingier Drilling, Inc.
Address 320 Union Natl Bldg., Wichita Kansas

STATE OF Kansas, COUNTY OF Sedgwick, ss. A. J. Carter (employee of ~~owner~~ operator) of the above-described

well, being first duly sworn on oath, says: That I have knowledge of the facts, statements, and matters herein contained and the log of the above-described well as filed and that the same are true and correct. So help me God.

(Signature) A. J. Carter, Jr.

320 Union Natl Bldg., Wichita
(Address)

SUBSCRIBED AND SWORN TO before me this 27th day of April, 1953

Marjorie Broadbent
Notary Public.

My commission expires March 7, 1956

24-2675-5

RECEIVED
STATE CORPORATION COMMISSION
FILE SEC-3 T-31 R-42W
BOOK PAGE 95 LINE 43
4-29-53 APR 29 1953
CONSERVATION DIVISION

DRILLERS LOG

HAAS #1
 NW NW NE Sec. 3-31S-12W
 Barber County, Kansas

Owner: W. C. Doenges
 Operator &
 Contractor: Coppinger Drilling, Inc.

Casing Record:

8-5/8" set at 380' with 250 sx posmix

Clay and sand	50
Clay, sand & red bed	200
Red bed and shells	375
Red bed and shale	382
Red bed and shells	600
Shale and shells	780
Shale, shells & red bed	835
Anhydrite	865
Shale and shells	1600
Lime and shale	1760
Lime	1805
Lime and shale	2165
Lime	2205
Lime and shale	2430
Lime	2520
Lime and shale	3060
Sandy lime	3165
Lime, shale & sand	3240
Shale	3340
Shale and lime	3415
Sand	3500
Lime and shale	3620
Shale and sandy lime	3695
Shale and sand	3750
Lime and shale	3829
Lime	4042
Lime and shale	4072
Lime	4174
Lime and shale	4254
Chert	4302
Chert and lime	4317
Chert	4344
Chert, lime & shale	4365
Shale and lime	4425
Shale	4445
Shale and lime	4510
Shale and cherty lime	4526
Lime and shale	4602
Sand, lime & Shale	4654
Shale and lime	4720
Lime	4732

Formations:

T Anhydrite	840
T Topeka	3119
T Elgin Sand	3436
T Heebner	3547
T Douglas	3575
T Lansing	3749
T Miss. Lime	4239
T Viola	4516
T Simpson	4574
T Arbuckle	4692

Total Depth 4732
 Commenced: March 29, 1953
 Completed: April 22, 1953
 Elevation: 1652 D.F.

TD 4732

STATE OF KANSAS
 COUNTY OF SEDGWICK SS.

I, the undersigned, being duly sworn on oath, state that the above statement and log is a true and correct record and log of the well drilled at the location above described.

Subscribed and sworn to before me this 27th day of April, 1953.

My commission expires: March 7, 1956

APR 29 1953

CONSERVATION DIVISION
 MINNERS, KANSAS

W. C. Doenges
 Notary Public

PLUGGING
 FILE SEC 3-T 31-12W
 BOOK PAGE 95 LINE 43