


WELL PLUGGING RECORD

Give All Information Completely
Make Required Affidavit
Mail or Deliver Report to:
Conservation Division
State Corporation Commission
212 North Market, Insurance Bldg.
Wichita, Kansas

NORTH

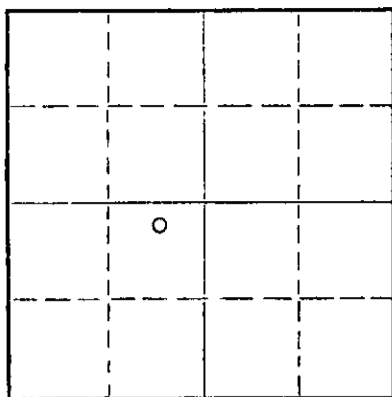

Locate well correctly on above Section Plat

Barber County, Sec. 1 Twp. 31S Rge. 12 (W)
Location as "NE/CNW/SE/SW" or footage from lines NE/4 NE/4 SW/4
Lease Owner Twin Drilling, Inc.
Lease Name Mott Well No. 1
Office Address 1005 Central Building, Wichita, Kansas
Character of Well (completed as Oil, Gas or Dry Hole) Dry Hole
Date well completed 6-13 19 59
Application for plugging filed 6-17 19 59
Application for plugging approved 6-22 19 59
Plugging commenced 6-13 19 59
Plugging completed 6-13 19 59
Reason for abandonment of well or producing formation Dry Hole

If a producing well is abandoned, date of last production 19
Was permission obtained from the Conservation Division or its agents before plugging was commenced? Yes

Name of Conservation Agent who supervised plugging of this well N. L. Lackamp, Stafford, Kansas
Producing formation Depth to top Bottom Total Depth of Well 4690 Feet
Show depth and thickness of all water, oil and gas formations.

OIL, GAS OR WATER RECORDS

CASING RECORD

FORMATION	CONTENT	FROM	TO	SIZE	PUT IN	PULLED OUT
				8 5/8"	283.22'	-

Describe in detail the manner in which the well was plugged, indicating where the mud fluid was placed and the method or methods used in introducing it into the hole. If cement or other plugs were used, state the character of same and depth placed, from feet to feet for each plug set.

Filled hole with rotary mud to 250'. Set plug and cement through drill pipe with 20 sacks cement. Filled hole up to 35' of base of cellar with mud. Set plug and cap with 10 sacks cement.

RECEIVED
STATE CORPORATION COMMISSION
JUN 26 1959
CONSERVATION DIVISION
Wichita, Kansas

(If additional description is necessary, use BACK of this sheet)
Name of Plugging Contractor Twin Drilling, Inc.
Address 1005 Central Building, Wichita, Kansas

STATE OF Kansas, COUNTY OF Sedgwick, ss.
C. R. Dunne (employed or owner) or (owner or operator) of the above-described well, being first duly sworn on oath, says: That I have knowledge of the facts, statements, and matters herein contained and the log of the above-described well as filed and that the same are true and correct. So help me God.

(Signature) *C. R. Dunne*
1005 Central Bldg., Wichita, Kansas
(Address)

SUBSCRIBED AND SWORN TO before me this 19th day of June, 19 59

Almeda Day
Notary Public.

My commission expires September 9, 1961

PLUGGING
FILE SEC 1 131 R12W
BOOK PAGE 44 LINE 25

WELL LOG

Well: Mott #1

Location: NE/4 NE/4 SW/4
Section 1-31S-12W
Barber County, Kansas

Contractor: Twin Drilling, Inc.
1005 Central Building
Wichita, Kansas

Operator: Same

Commenced: 5-29-59
Completed 6-13-59

Casing: 8 5/8" 283.22' w/250 sax

Surface	60
Shale & Lime Shells	277
Shells & Red Bed	1035
Shale & Lime Shells	1635
Shale & Shells	1685
Lime	1750
Lime Broken	1835
Lime	1960
Lime w/Shale Breaks	2290
Lime & Shale	2812
Shale w/Lime Streaks	2906
Lime Broken w/Sand Stks	3160
Shale	3338
Shale & Shells	3448
Shale w/Sand Streaks	3495
Shale & Lime	3569
Sand & Limey Shale	3711
Lime	4379
Shale	4555
Lime	4560
Lime-Cherty	4589
Lime	4640
Sand	4690

<u>TOPS</u>	
Elgin	3438
Heebner	3540
Upper Douglas	3598
Tonganoxie	3696
Iatan	3726
Lansing	3742
Conglomerate	4272
Mississippi	4288
Kinderhook	4377
Viola	4553
Simpson Shale	4634
Simpson Dolomite	4641
Simpson Sandstone	4654
Welex T.D.	4688

R.T.D. 4690'
D & A

STATE OF KANSAS)
) SS.
COUNTY OF SEDGWICK)

The Undersigned, TWIN DRILLING, INC., hereby certifies that the above log is a true and correct log of the formations encountered in drilling the above well as reflected by the Daily Drilling Report.

TWIN DRILLING, INC.

By Alameda Day

Subscribed and sworn to before me this 19th day of June, 1959.

James L. Hicker
Notary Public

My commission expires
September 29, 1960

RECEIVED
STATE CORPORATION COMMISSION

JUN 26 1959

CONSERVATION DIVISION

PLUGGING
FILE SEC 1 131 R424
BOOK PAGE 46 LINE 25