


STATE OF KANSAS  
STATE CORPORATION COMMISSION

WELL PLUGGING RECORD

Give All Information Completely  
Make Required Affidavit  
Mail or Deliver Report to:  
Conservation Division  
State Corporation Commission  
800 Biting Building  
Wichita, Kansas

NORTH

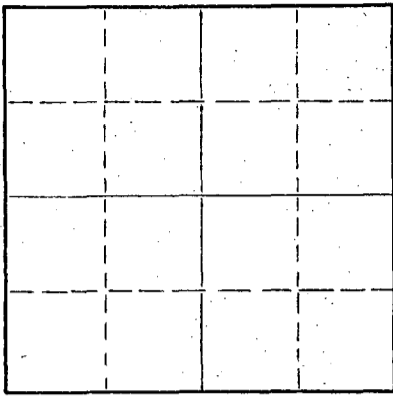

Locate well correctly on above  
Section Plat

Barber County, Sedgwick Twp 31S Rge 12 (E) (W)  
Location as "NE/CNW/SW" or footage from lines NE NE SW  
Lease Owner Winter #1 - Orville Parker  
Lease Name Winter #1 Well No. \_\_\_\_\_  
Office Address 402 A. C. Office Bldg., Arkansas City, Kansas  
Character of Well (completed as Oil, Gas or Dry Hole) Dry Hole  
Date well completed August 22, 19 54  
Application for plugging filed August 22, 19 54  
Application for plugging approved August 22, 19 54  
Plugging commenced 8:00 a.m. August 22, 19 54  
Plugging completed 8:00 p.m. August 22, 19 54  
Reason for abandonment of well or producing formation  
commercial quantity of oil not found  
If a producing well is abandoned, date of last production \_\_\_\_\_ 19 \_\_\_\_  
Was permission obtained from the Conservation Division or its agents before plugging was commenced? yes

Name of Conservation Agent who supervised plugging of this well C. D. Stough, Box 207, Great Bend, Kansas  
Producing formation \_\_\_\_\_ Depth to top \_\_\_\_\_ Bottom \_\_\_\_\_ Total Depth of Well 4663' Feet  
Show depth and thickness of all water, oil and gas formations.

OIL, GAS OR WATER RECORDS

CASING RECORD

FORMATION	CONTENT	FROM	TO	SIZE	PUT IN	PULLED OUT
				8 5/8	209'	

Describe in detail the manner in which the well was plugged, indicating where the mud fluid was placed and the method or methods used in introducing it into the hole. If cement or other plugs were used, state the character of same and depth placed, from \_\_\_\_\_ feet to \_\_\_\_\_ feet for each plug set.

Filled hole with heavy mud from 4663' to 200'. Set wooden plug with 20 sacks cement. Second plug at 35 ft. and capped with 10 sacks cement.

RECEIVED  
STATE CORPORATION COMMISSION  
AUG 28 1954  
CONSERVATION DIVISION  
Wichita, Kansas

(If additional description is necessary, use BACK of this sheet)  
Name of Plugging Contractor K & E Drilling, Inc.  
Address 1006 Central Bldg., Wichita, Kansas

STATE OF Kansas, COUNTY OF Sedgwick, ss.  
Agent for (employee of owner) or (owner or operator) of the above-described well, being first duly sworn on oath, says: That I have knowledge of the facts, statements, and matters herein contained and the log of the above-described well as filed and that the same are true and correct. So help me God.

(Signature) Walter Stough  
(Address) \_\_\_\_\_

SUBSCRIBED AND SWORN TO before me this 27th day of August, 19 54  
Francis Marder  
Notary Public.

My commission expires June 25, 1956

PLUGGING  
FILE SEC. 28 T. 31 R. 12W  
BOOK PAGE 58 LINE 45

ORVILLE PARKER  
WINTER #1

NE NE SW 18-31S-12W  
Barber County, Kansas

Casing

Cement

8 5/8" Set @ 209'

135 sacks

Comm: July 30, 1954  
Comp: August 22, 1954  
Total Depth: 4663'

<u>FORMATION</u>	<u>DEPTH</u>
Sand & shale	0 - 40
Shale & shells	40 - 205
Red bed & red rock	205 - 590
Shale & shells	590 - 1150
Lime & shale	1150 - 1418
Anhydrite	1418 - 1428
Shale & shells	1428 - 1450
Lime	1450 - 2305
Shale & lime	2305 - 2369
Shale & shells	2369 - 2500
Lime & shale	2500 - 2620
Shale w/ some lime	2620 - 2705
Shaled lime	2705 - 2815
Lime & shale	2815 - 2920
Lime & shale streaks	2920 - 3005
Lime & shale	3005 - 3185
Shale w/ some lime	3185 - 3281
Shale - lime streaks	3281 - 3370
Elgin sand	3370 - 3431
Sand - Elgin	3431 - 3433
Sandy shale	3433 - 3510
Lime & arbuckle	3510 - 3570
Shale & lime	3570 - 3597
Douglas sand	3597 - 3610
Sand - Douglas	3610 - 3626
Sand	3626 - 3634
Lime shale	3634 - 3648
Shale & lime	3648 - 3708
Sand w/ shale	3676 - 3708
Broken lime & shale	3708 - 3733
Kansas City lime	3733 - 3811
Lime	3811 - 4046
Lime - hard	4046 - 4060
Broken lime	4060 - 4085
Broken lime w/ shale	4085 - 4119
Lime	4119 - 4201
Lime & shale	4201 - 4219
Mississippi lime	4219 - 4240
Shale & lime	4240 - 4270
Cherty lime	4270 - 4303
Shale & cherty lime	4303 - 4321
Lime & block kinderhook shale	4321 - 4342
Kinderhook	4342 - 4391
Kinderhook lime	4391 - 4400
Shale stringer	4400 - 4427
Viola lime	4427 - 4444
Viola chert & lime	4444 - 4464
Lime	4464 - 4483
Cherty lime w/ some shale	4483 - 4503
Cherty lime	4503 - 4523
Simpson sand & shale	4523 - 4569
Lime & shale - some sand	4569 - 4590
Shale & sand streaks	4590 - 4622
Shale	4622 - 4630
Arbuckle	4630 - 4663

REEL  
STATE CONTROL

AUG 28 1954

CONSERVATION DIVISION

Wichita, Kansas

PLUGGING  
WELL NO. 18-31-12W  
PAGE 58 LINE 45

STATE OF KANSAS )  
 ) SS  
SEDGWICK COUNTY )

I hereby certify that the above information is true and correct to the best of my knowledge.

*[Signature]*

Subscribed and sworn to before me this 26th day of August, 1954.

My commission expires: June 25, 1956

*Francis Miller*