

STATE OF KANSAS
STATE CORPORATION COMMISSION


WELL PLUGGING RECORD

Give All Information Completely
Make Required Affidavit
Mail or Deliver Report to:
Conservation Division
State Corporation Commission
212 North Market, Insurance Bldg.
Wichita, Kansas

Barber County, Sec. 18 Twp. 31S Rge. (E) 12 (W)

Location as "NE/CNW&SW" or footage from lines. Approx. C NE SE
Lease Owner K & E Drilling, Inc.
Lease Name GRESS "B" Well No. 1
Office Address 719 Union Center, Wichita, Kansas 67202
Character of Well (completed as Oil, Gas or Dry Hole) Dry Hole
Date well completed 2-18-66 19
Application for plugging filed 2-18-66 19
Application for plugging approved 2-18-66 19
Plugging commenced 2-18-66 19
Plugging completed 2-18-66 19
Reason for abandonment of well or producing formation dry

NORTH

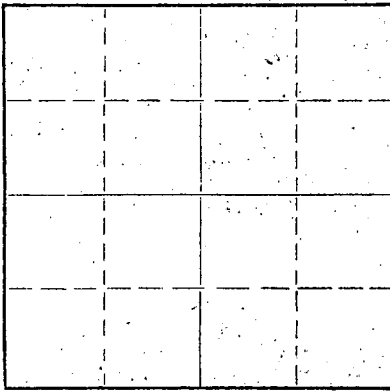

Locate well correctly on above
Section Plat

If a producing well is abandoned, date of last production _____ 19____
Was permission obtained from the Conservation Division or its agents before plugging was commenced? yes

Name of Conservation Agent who supervised plugging of this well A. Elving, Pratt, Kansas
Producing formation _____ Depth to top _____ Bottom _____ Total Depth of Well 3777 Feet
Show depth and thickness of all water, oil and gas formations.

OIL, GAS OR WATER RECORDS

CASING RECORD

FORMATION	CONTENT	FROM	TO	SIZE	PUT IN	PULLED OUT
				8-5/8"	264'	-0-

Describe in detail the manner in which the well was plugged, indicating where the mud fluid was placed and the method or methods used in introducing it into the hole. If cement or other plugs were used, state the character of same and depth placed, from _____ feet to _____ feet for each plug set.

Heavy mud 260', 9' bridge w/25 sx. cement
Heavy mud to 40' bridge w/1/2 sack hulls & plug 10 sx. cement to base of collar. 2 sx. cement in rathole.

RECEIVED
STATE CORPORATION COMMISSION

FEB 24 1966

CONSERVATION DIVISION
Wichita, Kansas

Name of Plugging Contractor K & E DRILLING, INC. (If additional description is necessary, use BACK of this sheet)
Address 719 Union Center, Wichita, Kansas 67202

STATE OF Kansas, COUNTY OF Sedgwick, ss.
H. L. Wilson (employee of owner ~~XXXXXX~~ or owner or operator) of the above-described well, being first duly sworn on oath, says: That I have knowledge of the facts, statements, and matters herein contained and the log of the above-described well as filed and that the same are true and correct. So help me God.

(Signature) H. L. Wilson
719 Union Center, Wichita, Kansas (Address)

SUBSCRIBED AND SWORN TO before me this 23rd day of February 1966

My commission expires 8-30-69

Julene M. Bannon Notary Public.



DRILLER'S WELL LOG

OPERATOR: K & E DRILLING, INC.
719 Union Center
Wichita, Kansas 67202

WELL NAME: #1 Gress "B"
LOCATION: Approx. C NE SE
Section 18-31S-12W
Barber County, Kansas

CONTRACTOR: K & E DRILLING, INC.
719 UNION CENTER BLDG.
WICHITA, KANSAS

COMMENCED: 2-8-66

CASING RECORD: 8-5/8" @ 264' w/175 sx.

COMPLETED: 2-18-66

ROTARY TOTAL DEPTH: 3777

ELEVATION: 1650 Grd. 1659 K.B.

PRODUCTION: D & A

FORMATION RECORD

Depths shown indicate bottom of formations encountered.

Sand	30
Red Bed & Shale, Str. Sand	264
Red Bed & Shale	1190
Shale & Shells	1730
Lime & Shale	1900
Lime	3777

RECEIVED
STATE CORPORATION COMMISSION

FEB 24 1966

CERTIFICATION

CONSERVATION DIVISION
Wichita, Kansas

State of KANSAS }
County of SEDGWICK } ss:

I, Wayne L. Brinegar of K & E DRILLING, INC., upon oath state that the above and foregoing is a true and correct copy of the Driller's Log of the above named well.

Subscribed and sworn to before me this 23rd day of February, 1966

My Commission expires: 8-30-69

Wayne L. Brinegar
Wayne L. Brinegar

Julene M. Bannon
Julene M. Bannon, Notary Public



UP
1
C
NE
SE
18-31S-12W
Barber County, Kansas
2-8-66
2-18-66
1650 Grd. 1659 K.B.
D & A

