


STATE OF KANSAS  
STATE CORPORATION COMMISSION  
200 Colorado Derby Bldg.  
Wichita, Kansas 67202

Form CP-4  
Rev. 12-15-80

WELL PLUGGING RECORD

Give All Information Completely  
Make Required Affidavit

COUNTY Barber SEC 15 TWP. 31 S RGE. 12 XXW  
Location as in quarters or footage from lines:  
660' from north line, 660' from west line

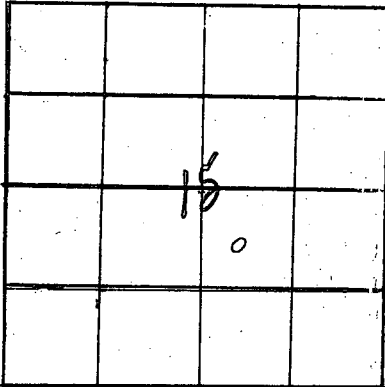

Locate Well  
correctly on above  
Section Platt.

Lease Owner George R. Jones  
Lease Name Pike Well No. 1  
Office Address 125 North Market Suite 1210 Wichita, Kansas  
Character of Well (Completed as ~~Oil~~, ~~Gas~~ or ~~Drill~~): Oil  
Date Well Completed Sept. 3, 1982  
Application for plugging filed Sept. 10, 1984  
Plugging commenced Sept. 20, 1984  
Plugging completed Sept. 24, 1984  
Reason for abandonment of well or producing formation not economical to produce

Was permission obtained from the Conservation Division or it's Agent's before plugging was commenced? yes

Name of Conservation Agent who supervised plugging of this well Steve Durant gave orders  
Producing formation Mississippian Depth to top            bottom T.D. 4720'

Show depth and thickness of all water, oil and gas formations.

OIL, GAS OR WATER RECORDS

Casing Record

Formation	Content	From	To	Size	Put in	Pulled Out
		0	369'	8 5/8	369'	0
		369'		4 1/2		3698'


Describe in detail the manner in which the well was plugged, indicating where the mud fluid was placed and the method or methods used in introducing it into the hold. If cement or other plugs were used, state the character of same and depth placed, from            feet to            feet for each plug set. Plug back TD 4665.13'

Mixed 35 sx. 60/40 poz, 1 sx. hulls, pumped plug to 3795' with 62 1/2 bbls. fresh water, squeezed off at 1500#, held for 5 minutes, released to 500#, shut in. Sun Oilwell cementing--3 sx. hulls, 10 sx. gel. 50 sx. cement, 10 sx. gel, 1 sx. hulls, 125 sx. 60/40 poz mix, 3% CC, 2% gel. Beginning pressure 500#, max. press. 700#, SIP 600#.

RECEIVED  
STATE CORPORATION COMMISSION

(If additional description is necessary, use BACK of this sheet) OCT 11 1984  
Name of Plugging Contractor Pratt Well Service, Inc. CONSERVATION DIVISION  
Wichita Kansas

STATE OF Kansas COUNTY OF Pratt, ss.  
Judy Berry (employee of owner) or (~~owner or operator~~) of the above-described well, being first duly sworn on oath, says: That I have knowledge of the facts, statements, and matters herein contained and the log of the above-described well as filed and that the same are true and correct. So help me God.

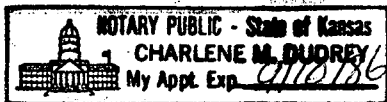

(Signature) Judy Berry  
Box 847 Pratt, Kansas  
(Address)

SUBSCRIBED AND SWORN TO before me this 10th day of October, 1984  
Charlene M. Dudley  
Notary Public.

My Commission expires: 11/10/86