

WELL PLUGGING RECORD

Give All Information Completely
Make Required Affidavit
Mail or Deliver Report to:
Conservation Division
State Corporation Commission
211 No. Broadway
Wichita, Kansas

BARBER

County. Sec. 35 Twp. 31 Rge. 10 (X) W (W)

Location as "NE/CNW&SW&" or footage from lines SW SW NW

Lease Owner PETROLEUM, INC.

Lease Name BEST ESTATE Well No. 1

Office Address ROUTE 2, GREAT BEND, KANSAS

Character of Well (completed as Oil, Gas or Dry Hole) DRY HOLE

Date well completed December 23, 19 57

Application for plugging filed December 24, 19 57

Application for plugging approved December 23, 19 57

Plugging commenced December 23, 19 57

Plugging completed December 23, 19 57

Reason for abandonment of well or producing formation

No Producing Zones

If a producing well is abandoned, date of last production None 19

Was permission obtained from the Conservation Division or its agents before plugging was commenced? Yes

Name of Conservation Agent who supervised plugging of this well M.A. Rives, Box 8, Pratt, Kansas

Producing formation ----- Depth to top --- Bottom --- Total Depth of Well 4580 Feet

Show depth and thickness of all water, oil and gas formations.

OIL, GAS OR WATER RECORDS

CASING RECORD

FORMATION	CONTENT	FROM	TO	SIZE	PUT IN	PULLED OUT
				8-5/8"	254'	None

Describe in detail the manner in which the well was plugged, indicating where the mud fluid was placed and the method or methods used in introducing it into the hole. If cement or other plugs were used, state the character of same and depth placed, from _____ feet to _____ feet for each plug set.

Mud up with heavy mud to 256', pushed down 1/3 sack hulls to 256' followed by wooden plug. Placed 20 sacks cement through drill pipe on to plug. Mud up to 25' and placed 1/3 sack hulls at 25' followed by wooden plug and 10 sacks cement to base of well cellar.

RECEIVED
STATE CORPORATION COMMISSION
JAN 7 1958
CONSERVATION DIVISION
Wichita, Kansas

(If additional description is necessary, use BACK of this sheet)
Name of Plugging Contractor GARVEY DRILLING COMPANY
Address ROUTE 2, GREAT BEND, KANSAS

STATE OF KANSAS, COUNTY OF BARTON, ss.
Don Searle (employee of owner) or (owner or operator) of the above-described

well, being first duly sworn on oath, says: That I have knowledge of the facts, statements, and matters herein contained and the log of the above-described well as filed and that the same are true and correct. So help me God.

(Signature) Don Searle


Route 2, Great Bend, Kansas (Address)

SUBSCRIBED AND SWORN to before me this 6th day of January, 1958

Jed B. Brown
Notary Public.

My commission expires July 11, 1960

PLUGGING
FILE SEC. 35 T. 31 R. 10W
BOOK PAGE 72 LINE 8

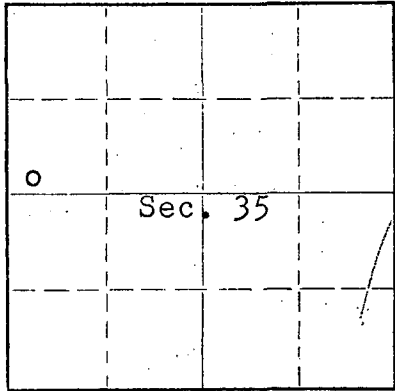

Locate well correctly on above Section Plat

WELL LOG

COMPANY PETROLEUM, INCORPORATED

SEC. 35 T. 31S R. 10W

FARM BEST ESTATE NO. 1


LOC. SW, SW, NW

TOTAL DEPTH 4580'

COUNTY BARBER CO., KANSAS

COMM. December 9, 1957 COMP. December 23, 1957

CONTRACTOR GARVEY DRILLING COMPANY

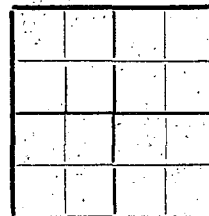

CASING 8 5/8" @ 254' W/175 sax.

ELEVATION 1645' DF

PRODUCTION D & A

FIGURES INDICATE BOTTOM OF FORMATIONS

135	Sand & Red rock"
256	Red bed
1130	Red bed & shale
1645	Shale & shells
1795	Lime & shale
1925	Lime
2620	Shale & lime
2850	Shale
3495	Lime & shale
3608	Shale & sand
3795	Lime & shale
4297	Lime
4390	Lime & shale
4438	Lime
4500	Lime & shale
4525	Chert
4543	Lime
4555	Chert & lime
4580	Lime
4580	T. D.

RECEIVED
STATE CORPORATE COMMISSION

JAN 7 1958

CONSERVATION DIVISION
Wichita, Kansas

State of KANSAS }
County of BARTON } ss:

I, VERNE A. MORRIS of GARVEY DRILLING COMPANY

upon oath state that the above and foregoing is a true and correct copy of the log of the #1 BEST ESTATE well

Subscribed and sworn to before me this 6th day of JANUARY 19 58

My Commission Expires: July 11, 1960

Verne A. Morris
Notary Public

PLUGGING
FILE SEC 35 T31 R10W
BOOK PAGE 72 LINE 8