


STATE OF KANSAS  
STATE CORPORATION COMMISSION  
Give All Information Completely  
Make Required Affidavit  
Mail or Deliver Report to:  
Conservation Division  
State Corporation Commission  
211 No. Broadway  
Wichita, Kansas

WELL PLUGGING RECORD

Barber County, Sec. 32 Twp. 31S Rge. 10W (E) (W)  
Location as "NE/CNW/SW" or footage from lines SW SW NW  
Lease Owner Sierra Petroleum Co., Inc.  
Lease Name McReynolds (Washdown) Well No. 1  
Office Address 1015 Wichita Plaza Bldg., Wichita, Kansas  
Character of Well (completed as Oil, Gas or Dry Hole) Dry Hole  
Date well completed September 23 19 65  
Application for plugging filed September 23 19 65  
Application for plugging approved September 23 19 65  
Plugging commenced September 23 19 65  
Plugging completed September 23 19 65  
Reason for abandonment of well or producing formation Dry Hole

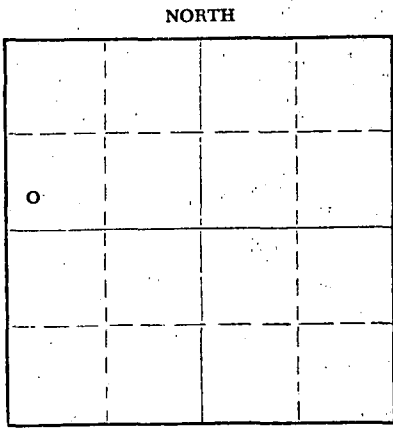

If a producing well is abandoned, date of last production -0- 19  
Was permission obtained from the Conservation Division or its agents before plugging was commenced? Yes

Name of Conservation Agent who supervised plugging of this well Archie V. Elving, Pratt, Kansas (old T.D. 5011')  
Producing formation Depth to top Bottom Total Depth of Well 3712 Feet  
Show depth and thickness of all water, oil and gas formations.

OIL, GAS OR WATER RECORDS

CASING RECORD

FORMATION	CONTENT	FROM	TO	SIZE	PUT IN	PULLED OUT
		0	257'	8"	257'	None

Describe in detail the manner in which the well was plugged, indicating where the mud fluid was placed and the method or methods used in introducing it into the hole. If cement or other plugs were used, state the character of same and depth placed, from feet to feet for each plug set.

Mud to 240' - Set Plug & 2 sacks cement & 1/3 sack Hulls, then 28 sacks cement.  
Top Plug @ 40'/1/3 sacks hulls and 10 sacks cement - 3 sacks cement in rat hole.

RECEIVED  
STATE CORPORATION COMMISSION

OCT 8 1965

CONSERVATION DIVISION  
Wichita, Kansas

(If additional description is necessary, use BACK of this sheet)

Name of Plugging Contractor Hellar Drilling Company, Inc.  
Address 1014 Union Center, Wichita, Kansas

STATE OF Kansas, COUNTY OF Sedgwick, ss.  
D. L. Hellar, President of Hellar Drilg. Co. Inc. (employee of owner) or (owner or operator) of the above-described well, being first duly sworn on oath, says: That I have knowledge of the facts, statements, and matters herein contained and the log of the above-described well as filed and that the same are true and correct. So help me God.

(Signature) *D. L. Hellar* President - D. L. Hellar  
1014 Union Center, Wichita, Kansas 67202  
(Address)

SUBSCRIBED AND SWORN TO before me this 7th day of October, 19 65

My commission expires March 25, 1968

*Catherine Darcey*  
Catherine Darcey Notary Public.