


Give All Information Completely
Make Required Affidavit
Mail or Deliver Report to:
Conservation Division
State Corporation Commission
211 No. Broadway
Wichita, Kansas

WELL PLUGGING RECORD

NORTH

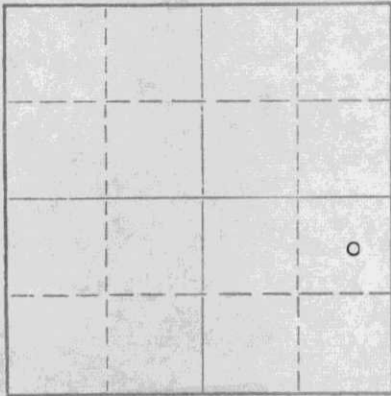

Locate well correctly on above
Section Plat

Barber County, Sec. 6 Twp. 31 Rge. (E) 12 (W)
Location as "NE/CNW/SW" or footage from lines 20' NE of C NE SE
Lease Owner Colorado Oil Company
Lease Name Kumberg Well No. 1-6
Office Address 915 Union Natl. Bldg., Wichita, Kansas 67202
Character of Well (completed as Oil, Gas or Dry Hole) Dry Hole
Date well completed June 24 19 67
Application for plugging filed June 24 19 67
Application for plugging approved June 24 19 67
Plugging commenced June 24 19 67
Plugging completed June 24 19 67
Reason for abandonment of well or producing formation

If a producing well is abandoned, date of last production 19
Was permission obtained from the Conservation Division or its agents before plugging was commenced? Yes

Name of Conservation Agent who supervised plugging of this well Archie V. Elving
Producing formation Depth to top Bottom Total Depth of Well 3772 Feet
Show depth and thickness of all water, oil and gas formations.

OIL, GAS OR WATER RECORDS

CASING RECORD

FORMATION	CONTENT	FROM	TO	SIZE	PUT IN	PULLED OUT
				8-5/8"	214	None

Describe in detail the manner in which the well was plugged, indicating where the mud fluid was placed and the method or methods used in introducing it into the hole. If cement or other plugs were used, state the character of same and depth placed, from feet to feet for each plug set.

3772' - 200' Mud
Bridge @ 200' w/wooden plug, 2 sacks cement, 1 sack hulls
195' - 125' 25 sacks cement
125' - 40' Mud
Bridge @ 40' w/wooden plug, 2 sacks cement, 1 sack hulls
35' - 6' 10 sacks cement
6' to surface
2 sacks cement in rat hole

RECEIVED
STATE CORPORATION COMMISSION

JUN 29 1967

CONSERVATION DIVISION
Wichita, Kansas

(If additional description is necessary, use BACK of this sheet)

Name of Plugging Contractor Hellar Drilling Company, Inc.
Address 1014 Union Center, Wichita, Kansas 67202

STATE OF Kansas, COUNTY OF Sedgwick, ss.
Bill K. Henrichs (employee of owner) or (xxxxxx) of the above-described well, being first duly sworn on oath, says: That I have knowledge of the facts, statements, and matters herein contained and the log of the above-described well as filed and that the same are true and correct. So help me God.

(Signature) Bill K. Henrichs *Bill K Henrichs*
915 Union Natl. Bldg., Wichita, Kansas
(Address)

SUBSCRIBED AND SWORN TO before me this 28th day of June, 1967

My commission expires Aug. 19, 1967

Helen L. Martin
Helen L. Martin Notary Public.

DRILLER'S LOG

COMPANY: Colorado Oil Company, 915 Union National Bldg., Wichita, Ks
CONTRACTOR: Hellar Drilling Company, Inc., Wichita, Kansas
LEASE: Kumberg #1-6
LOCATION: 20' NE of C NE SE 6-31S-12W, Barber County, Kansas
COMMENCED: June 15, 1967
COMPLETED: June 24, 1967
CASING: Set 8 5/8" surface casing @ 214'/175 sacks cement

0-830	Red Bed
830-1563	Shale, Red Bed, Salt
1563-1730	Salt Section
1730-2205	Ft. Riley
2205-3732	Lime & Shale
3732-3742	Douglas Sand
3742-3772	Douglas
3772	Rotary Total Depth

D & A

RECEIVED
STATE CORPORATION COMMISSION
JUN 28 1967
CONSERVATION DIVISION
Wichita, Kansas

STATE OF KANSAS)
) SS
COUNTY OF SEDGWICK)

I, D. L. Hellar, do hereby certify that the above and foregoing is a true and correct copy of the log of the Kumberg #1-6, located 20' NE of C NE SE 6-31S-12W, Barber County, Kansas, as reflected by the files of the Hellar Drilling Company, Inc.

HELLAR DRILLING COMPANY, INC.

By *D. L. Hellar*
President - D. L. Hellar

Subscribed and sworn to before me, a Notary Public, in and for Sedgwick County, Kansas, this 26th day of June, 1967.

My Commission Expires:
March 25, 1968.

Catherine Darcey
Notary Public - Catherine Darcey