


WELL PLUGGING RECORD

Give All Information Completely
Make Required Affidavit
Mail or Deliver Report to:
Conservation Division
State Corporation Commission
211 No. Broadway
Wichita, Kansas

Barber County, Sec. 22 Twp. 31 Rge. 12 ~~12~~ (W)

NORTH

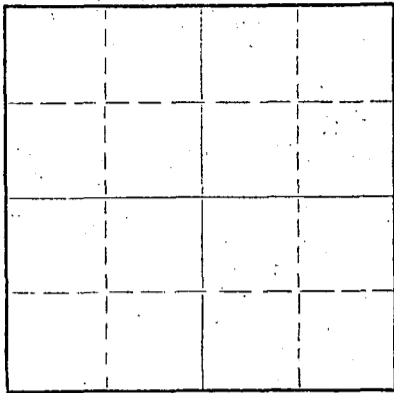

Locate well correctly on above
Section Plat

Location as "NE/CNW/SW" or footage from lines C SE SE
Lease Owner Aylward Drilling Company
Lease Name Updegraff Well No. 1
Office Address 813 1st National Bank Bldg., Wichita, Kansas
Character of Well (completed as Oil, Gas or Dry Hole) Dry Hole
Date well completed October 10 19 56
Application for plugging filed October 10 19 56
Application for plugging approved October 10 19 56
Plugging commenced October 10 19 56
Plugging completed October 10 19 56
Reason for abandonment of well or producing formation Dry Hole

If a producing well is abandoned, date of last production _____ 19____
Was permission obtained from the Conservation Division or its agents before plugging was commenced? Yes

Name of Conservation Agent who supervised plugging of this well M. A. Rives - Pratt, Kansas
Producing formation _____ Depth to top _____ Bottom _____ Total Depth of Well 4825 Feet
Show depth and thickness of all water, oil and gas formations.

OIL, GAS OR WATER RECORDS

CASING RECORD

FORMATION	CONTENT	FROM	TO	SIZE	PUT IN	PULLED OUT
				8 5/8"	200'	None

Describe in detail the manner in which the well was plugged, indicating where the mud fluid was placed and the method or methods used in introducing it into the hole. If cement or other plugs were used, state the character of same and depth placed, from _____ feet to _____ feet for each plug set.
Filled hole with heavy mud from T. D. to 200'; cement plug from 200' to 140' with 20 sacks cement; heavy mud from 140' to 40'; cement plug from 40' to top of surface with 10 sacks cement.

RECEIVED
STATE CORPORATION COMMISSION
OCT 22 1956
CONSERVATION DIVISION
Wichita, Kansas

(If additional description is necessary, use BACK of this sheet)
Name of Plugging Contractor Aylward Drilling Company
Address 813 1st National Bank Building, Wichita, Kansas

STATE OF Kansas, COUNTY OF Sedgwick, ss.
Paul W. Hesse (employee of owner) ~~(owner or operator)~~ of the above-described well, being first duly sworn on oath, says: That I have knowledge of the facts, statements, and matters herein contained and the log of the above-described well as filed and that the same are true and correct. So help me God.

(Signature) Paul W. Hesse
813 1st Nat'l Bank Bldg., Wichita, Kansas
(Address)

SUBSCRIBED AND SWORN TO before me this 15th day of October, 1956

My commission expires December 11, 1957
Duane Jessup Notary Public.

PLUGGING
FILE SEC. 22 T. 31 R. 12 W.
BOOK PAGE 106 LINE 75

UPDEGRAFF #1

Casing Record:

8 5/8" - 196'

Company: Aylward Drilling Company
Contractor: Aylward Drilling Company

Commenced: September 17, 1956
Completed: October 10, 1956

Location: C SE SE
Section 22-31-12W
Barber County,
Kansas

Elev. 1624 R.B.

	<u>From</u>	<u>To</u>	<u>Remarks</u>
Red Bed	0	690	Set 8 5/8" @ 196' w/150 sx cement
Red Rock	690	900	
Shale & Shelves Red Rock	900	1140	DST #1 4122-4166 Open 1 1/2 Hrs. Good blow through-
Shale & Shells	1140	1350	out. Rec. 440' Salt Water. ISIP 1690#/20 min.
Salt	1350	1410	FP 60#-485#, FBHP 1580#/30 min.
Anhydrite Lime	1410	1485	
Lime and Shale	1485	1690	DST #2 4305-4327 Open 1 1/2 hr. Gas to surf. in
Lime and Shale	1690	1850	28 min. (Too small to measure) Rec. 38' GCM
Lime	1850	1930	ISIP 1375#/20 min., FP 0, FBHP 965#/30 min.
Lime & Shale	1930	3055	
Lime	3055	3285	DST #3 4327-4347 Open 1 1/2 hrs. Good blow through-
Shale & Lime=	3285	3569	out. Rec. 600' gas & 100' VSO&GCM. ISIP 1515#/ 30 min., FP 0, FBHP 140#/30 min.
Sandy Lime & Shale	3569	3646	
Shale & Sand	3646	3712	
Sand	3712	3771	DST #4 4347-4384 Open 1 1/2 hrs. Good blow dec. to
Lime	3771	4166	weak. Rec. 130' VSO&GCM. ISIP 1745#/30 min.
Lime & Shale	4166	4311	FP 110#/125#, FBHP 200#/30 min.
Miss. Chert	4311	4327	
Chat Lime	4327	4347	GEOLOGICAL TOPS:
Chert & Lime	4347	4377	Elgin Sand No Tops
Cherty Lime	4377	4384	Heebner 3576
Lime	4384	4469	Base/Oread 3611
Lime & Shale	4469	4486	Douglas Sand 3641
Shale & Lime	4486	4621	Brown Lime 3770
Lime	4621	4637	Lansing= 3780
Cherty Lime	4637	4657	Base/K.C. 4230
Lime	4657	4674	Mississippian 4311
Lime & Sand	4674	4702	Kinderhook Shale 4477
Sand	4702	4733	Chattanooga Shale 4568
Lime	4733	4751	Viola 4605
Lime & Shale	4751	4788	Simpson Shale 4685
Lime & Sand	4788	4825	R.T.D. Arbuckle 4790
			R.T.D. 4825 D. & A.

I hereby certify that this is a true and correct copy of the above log to the best of my knowledge.

Paul W. Heese

Subscribed and sworn to before me this 16th day of October, 1956.

Duane Jessup
Notary Public

My commission expires December 11, 1957

RECEIVED
STATE CORPORATION COMMISSION
OCT 22 1956
CONSERVATION DIVISION
Wichita, Kansas

PLUGGING	
FILE SEC. 22 T. 31 R. 12W	
BOOK PAGE 106 LINE 75	