


STATE OF KANSAS
STATE CORPORATION COMMISSION

WELL PLUGGING RECORD

Give All Information Completely
Make Required Affidavit
Mail or Deliver Report to
Conservation Division
State Corporation Comm.
245 North Water
Wichita, KS 67202

Barber County, Sec. 22 Twp. 31S Rge. 12 ~~W~~/W
Location as "NE/CNW $\frac{1}{4}$ SW $\frac{1}{4}$ " or footage from lines
NW SE SW

Lease Owner Graves Drilling Co., Inc.
Lease Name Youngers Well No. 2
Office Address 910 Union Center, Wichita, Kansas 67202
Character of Well (Completed as Oil, Gas or Dry Hole)
Dry Hole

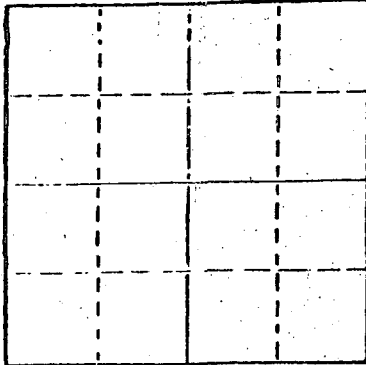

Locate well correctly on above
Section Plat

Date Well completed August 5, 1980
Application for plugging filed August 5, 1980
Application for plugging approved August 5, 1980
Plugging commenced August 5, 1980
Plugging completed August 5, 1980
Reason for abandonment of well or producing formation

If a producing well is abandoned, date of last production 19

Was permission obtained from the Conservation Division or
its agents before plugging was commenced? Yes

Name of Conservation Agent who supervised plugging of this well Wm. T. Owen, Pratt, Kansas
Producing formation Depth to top Bottom Total Depth of Well 4365'
Show depth and thickness of all water, oil and gas formations.

OIL, GAS OR WATER RECORDS

CASING RECORD

FORMATION	CONTENT	FROM	TO	SIZE	PUT IN	PULLED OUT
				8-5/8"	220'	None

Describe in detail the manner in which the well was plugged, indicating where the mud fluid was placed and the method or methods used in introducing it into the hold. If cement or other plugs were used, state the character of same and depth placed, from feet to feet for each plug set.

Pumped 40 sacks cement through drill pipe to 210 feet. Pushed plug & hulls to 40 feet with 10 sacks cement. Plugged rat hole with 5 sacks cement.

RECEIVED
STATE CORPORATION COMMISSION

AUG 20 1980

(If additional description is necessary, use BACK of this sheet)
Name of Plugging Contractor Graves Drilling Co., Inc. CONSERVATION DIVISION
Wichita, Kansas

STATE OF KANSAS COUNTY OF SEDGWICK, ss.
John C. Graves (employee of owner) or (owner or operator)

of the above-described well, being first duly sworn on oath, says: That I have knowledge of the facts, statements, and matters herein contained and the log of the above-described well as filed and that the same are true and correct. So help me God

(Signature) John C. Graves
910 Union Center, Wichita, Kansas 67202
(Address)

SUBSCRIBED AND SWORN TO before me this 19th day of August, 1980

My commission expires May 9, 1983

Betty Brandt
Betty Brandt Notary Public.

ROTARY DRILLERS' LOG

OPERATOR: Graves Drilling Co., Inc.
910 Union Center }
Wichita, Kansas 67202

DRILLING COMMENCED: July 29, 1980

CONTRACTOR: Graves Drilling Co., Inc.
910 Union Center }
Wichita, Kansas 67202

DRILLING COMPLETED: August 5, 1980

CASING RECORD: 5 Jts. 220' of used 8-5/8"
cemented with 185 sacks.

LOCATION: Youngers No. 2
NW SE SW
Section 22-31S-12W
Barber County, Kansas

0 - 867 Red bed
867 - 1930 Red bed & shale
1930 - 3879 Shale & lime
3879 - 3951 Lime & shale
3951 - 4201 Shale & lime
4201 - 4306 Lime & shale
4306 - 4365 Shale & lime
4365 Rotary Total Depth

I hereby certify the foregoing statements to be true and correct to the best of my knowledge.

GRAVES DRILLING CO., INC.

Copy sent to:
State Corporation Commission
Kansas Geological Society
Kansas Geological Survey

By Betty Brandt
Secretary-Treasurer

RECEIVED
STATE CORPORATION COMMISSION

AUG 20 1980

CONSERVATION DIVISION
Wichita, Kansas

STATE OF KANSAS)
))
SEDGWICK COUNTY)

ss:--

Subscribed and sworn to before me, a Notary Public, this 19th day of August, 1980.

Rebecca L. Matthews
Rebecca L. Matthews Notary Public

My commission expires: May 17, 1983.