


WELL PLUGGING RECORD

Give All Information Completely
Make Required Affidavit
Mail or Deliver Report to:
Conservation Division
State Corporation Commission
800 Bittling Building
Wichita, Kansas

NORTH

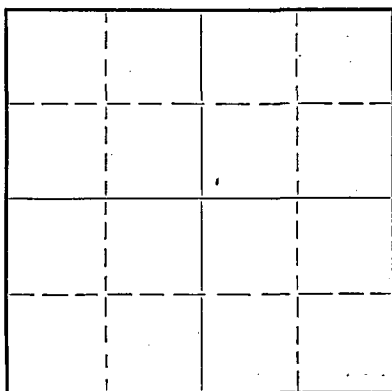

Locate well correctly on above
Section Plat

Barber County. Sec. 20 Twp. 31 S Rge. 12 (E) (W)

Location as "NE/CNW $\frac{1}{4}$ /SW $\frac{1}{4}$ " or footage from lines NW, NW, NW,

Lease Owner Beardmore Drilling Company, Inc. et al

Lease Name Calloway Well No. 1

Office Address 603 Petroleum Bldg., Wichita, Kansas

Character of Well (completed as Oil, Gas or Dry Hole) dry hole

Date well completed April 24, 19 51

Application for plugging filed April 24, 19 51

Application for plugging approved April 24, 19 51

Plugging commenced April 24, 19 51

Plugging completed April 24, 19 51

Reason for abandonment of well or producing formation dry hole

If a producing well is abandoned, date of last production 19

Was permission obtained from the Conservation Division or its agents before plugging was commenced? Yes

Name of Conservation Agent who supervised plugging of this well C. D. Stough

Producing formation Depth to top Bottom Total Depth of Well 4663 Feet

Show depth and thickness of all water, oil and gas formations.

OIL, GAS OR WATER RECORDS

CASING RECORD

Formation	Content	From	To	Size	Put In	Pulled Out
				8-5/8"	147'	none

Describe in detail the manner in which the well was plugged, indicating where the mud fluid was placed and the method or methods used in introducing it into the hole. If cement or other plugs were used, state the character of same and depth placed, from top feet to bottom feet for each plug set.

Mud to 145 ft. set plug and cemented with 15 sacks; mud to 30 ft set plug and cemented with 10 sacks to complete

RECEIVED
STATE CORPORATION COMMISSION

MAY 1 - 1951

CONSERVATION DIVISION
Wichita, Kansas

(If additional description is necessary, use BACK of this sheet)

Correspondence regarding this well should be addressed to Beardmore Drilling Company, Inc.
Address 603 Petroleum Bldg., Wichita, Kansas

STATE OF Kansas, COUNTY OF Sedgwick, ss.
Heber Beardmore (as proprietor) or (owner or operator) of the above-described well,

being first duly sworn on oath, says: That I have knowledge of the facts, statements, and matters herein contained and the log of the above-described well as filed and that the same are true and correct. So help me God

(Signature) Heber Beardmore

603 Petroleum Bldg., Wichita, Kansas
(Address)

SUBSCRIBED AND SWORN to before me this 25th day of April, 19 51

Annette A. Kennally
Notary Public.

My commission expires Jan. 19, 1955

PLUGGING
FILE SEC 20 T 31 R 20
BOOK PAGE 28 LINE 4

Calloway No. 1

NW, NW, NW,
Section 20-31-12W
Barber County, Kansas

Drilled for: Beardmore et al
Drilled by: Beardmore Drilling Co., Inc.

Casing Record:

8-5/8" 117' w/100 sacks

Drilling Commenced: April 1, 1951
Drilling Completed: April 24, 1951

Elevation: 1619 D.F.

FORMATION	DEPTH
Red bed	60
Red rock	130
Shale - shells	117
Red bed - shale	190
Shale - shells	1170
Shale - lime	1580
Lime	2200
Lime - shale	3570
Sand - shale	3600
Sand	3665
Sand - lime	3687
Lime - shale	3735
Lime	3825
Lime - shale blk	3875
Lime - shale	3915
Lime	3950
Lime - shale	4180
Lime - chert	4217
Shale - lime	4240
Lime	4337
Lime - shale	4380
Shale - lime	4395
Lime	4460
Lime - shale	4501
Sand	4514
Sand-lime	4545
Lime - shale	4561
Shale	4612
Lime	4663 T. D.

D & A

Tops:

Heebner Shale	3199
Lansing	3704
Mississippi	4195
Kinderhook	4312
Viola	4416
Simpson	4497
Arbuckle	4609

DST 4370
open 45 min.
Recov. 10' mud
NO BHP

DST 4494-4509
open 15 min
no blow
Recov. 15' mud
No BHP

STATE OF KANSAS
SS
COUNTY OF SEDGWICK

RECEIVED
STATE CORPORATION COMMISSION
MAY 1 - 1951
CONSERVATION DIVISION
Topeka, Kansas

I, the undersigned, being duly sworn on oath state that the above and within statement is a true and correct record and log of the well drilled on the location above described, to the best of my knowledge and belief.

PLUGGING
FILE SEC 20 T 31 R 12
BOOK PAGE 71 LINE 4

[Signature]

Subscribed and sworn to before me this 27th day of April, 1951.

[Signature]
Notary Public

My Commission Expires: 1/19/55