


15-007-20800-00-00

STATE OF KANSAS
STATE CORPORATION COMMISSION

WELL PLUGGING RECORD

Give All Information Completely
Make Required Affidavit
Mail or Deliver Report to
Conservation Division
State Corporation Comm.
245 North Water
Wichita, KS 67202

Barber County. Sec. 20 Twp. 31S Rge. 12W E/W
Location as "NE/CNW 1/4 SW 1/4" or footage from lines _____
660 FSL 1980 FEL
Lease Owner Texas Oil & Gas
Lease Name Gress Well No. B-1
Office Address 200 W. Douglas, Suite 300, Wichita, Kansas
Character of Well (Completed as Oil, Gas or Dry Hole) _____

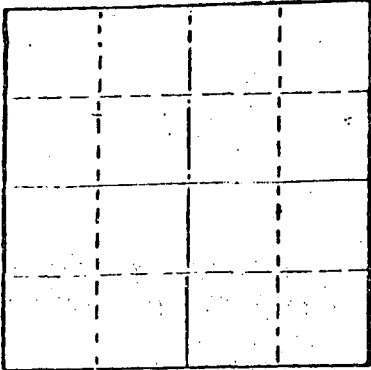

Locate well correctly on above
Section Plat

Dry
Date Well completed Oct. 15, 1979
Application for plugging filed 1-17 1980
Application for plugging approved 1-19 1980
Plugging commenced 1-24 1980
Plugging completed 2-1 1980
Reason for abandonment of well or producing formation _____

If a producing well is abandoned, date of last production _____
19 _____

Was permission obtained from the Conservation Division or
its agents before plugging was commenced? Yes

Name of Conservation Agent who supervised plugging of this well Bill Owens
Producing formation _____ Depth to top _____ Bottom _____ Total Depth of Well 4344
Show depth and thickness of all water, oil and gas formations.

OIL, GAS OR WATER RECORDS

CASING RECORD

FORMATION	CONTENT	FROM	TO	SIZE	PUT IN	PULLED OUT
				8 5/8	325	None
				2 7/8	4344	3032

Describe in detail the manner in which the well was plugged, indicating where the mud fluid was placed and the method or methods used in introducing it into the hold. If cement or other plugs were used, state the character of same and depth placed, from _____ feet to _____ feet for each plug set.

Allied Pump in 25 sacks common cement
Stop cement 3730

Shot off at 3500 3300 3032
Allied pum in

5- Hull
20 sacks Gel

100 sacks 50 - 50 POY

(If additional description is necessary, use BACK of this sheet)

Name of Plugging Contractor Clarke Corporation

RECEIVED
STATE CORPORATION COMMISSION

FEB 13 1980

CONSERVATION DIVISION
Wichita, Kansas

STATE OF Kansas COUNTY OF Barber, ss.
Elmo H. Mergestern (employee of owner) or (owner or operator)
of the above-described well being first duly sworn on oath, says: That I have knowledge of the facts, statements, and matters herein contained and the log of the above-described well as filed and that the same are true and correct. So help me God.

(Signature) Elmo H. Mergestern
Medicine Lodge, Kansas
(Address)

SUBSCRIBED AND SWORN TO before me this 5th day of February, 1980

Jessie Hamilton
Notary Public.

My commission expires April 4, 1982.

KANSAS DRILLERS LOG

COMPANY Texas Oil and Gas Corp.

SEC. 20 T. 31S R. 12W
LOC. 660' FNL & 1980' FE

FARM Gress "B" NO. 1

COUNTY Barber

ROTARY TOTAL DEPTH 4,360'
COMM. September 26, 1979 COMP. October 4, 1979
CONTRACTOR H-30, INC. (Rig #5)
ISSUED October 15, 1979

CASING

10 3/4"
8 5/8" Set at 325' cemented w/225 sxs cement
5 1/2"
4 1/2"
2 7/8" Set at 4,344' cemented w/200 sxs cement

ELEVATION 1,609' K.B.

Shale and Red Bed	345'
Red Bed and Shale	1,360'
Shale	2,050'
Lime and Shale	2,280'
Shale and Lime	3,070'
Lime and Shale	3,205'
Shale and Lime	3,653'
Lime and Shale	3,780'
Shale and Lime	4,075'
Lime and Shale	4,217'
Shale and Lime	4,360'
Rotary Total Depth	4,360'

FIGURES INDICATE BOTTOM OF FORMATIONS

I hereby certify the above and foregoing to be
a true and correct log of the above described
well as shown by the drilling reports.

H-30, INC.

Dean Britting
Dean Britting

State of Kansas }
County of Sedgwick } ss:

Subscribed and Sworn to before me a Notary Public
in and for said county and state this 15th day of
October, 1979.



Elsie Willison
Elsie Willison - Notary Public

My Commission Expires:
July 25, 1982

WELL : GROSS B #1

LOCATION : 660 PSL 1980 FEL SEC 20 31S 12W Barber Co.

ELEVATION : 1601' G.L. 1609' K.B.

