

STATE OF KANSAS  
STATE CORPORATION COMMISSION

Form CP-4

Give All Information Completely  
Make Required Affidavit  
Mail or Deliver Report to:  
Conservation Division  
State Corporation Commission  
212 No. Market  
Wichita, Kansas

WELL PLUGGING RECORD

Barber County, Sec. 24 Twp. 30S Rge. 11W (E) (W)

Location as "NE/CNW/SW" or footage from lines C SE NE

Lease Owner E. K. Edmiston

Lease Name MASSONI Well No. -1-

Office Address First National Bank Building, Wichita, Kansas

Character of Well (completed as Oil, Gas or Dry Hole) dry hole

Date well completed August 4, 1966 19

Application for plugging filed August 5, 1966 19

Application for plugging approved August 5, 1966 19


Plugging commenced August 5, 1966 19

Plugging completed August 5, 1966 19

Reason for abandonment of well or producing formation non-commercial

If a producing well is abandoned, date of last production -- 19

Was permission obtained from the Conservation Division or its agents before plugging was commenced? yes

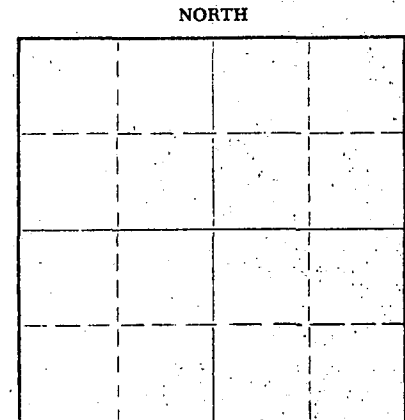

Locate well correctly on above Section Plat

Name of Conservation Agent who supervised plugging of this well Archie V. Elving

Producing formation -- Depth to top -- Bottom -- Total Depth of Well 4800 Feet

Show depth and thickness of all water, oil and gas formations.

OIL, GAS OR WATER RECORDS

CASING RECORD

FORMATION	CONTENT	FROM	TO	SIZE	PUT IN	PULLED OUT
				8-5/8"	255'	--

Describe in detail the manner in which the well was plugged, indicating where the mud fluid was placed and the method or methods used in introducing it into the hole. If cement or other plugs were used, state the character of same and depth placed, from -- feet to -- feet for each plug set.

Plug to 240' with 25 sacks cement and plug to 40 feet with 10 sacks cement, finished plugging hole 11 a.m.

RECEIVED  
STATE CORPORATION COMMISSION

AUG 10 1966

CONSERVATION DIVISION  
Wichita, Kansas

(If additional description is necessary, use BACK of this sheet)

Name of Plugging Contractor E. K. Edmiston Drilling Co., Inc.

Address First National Bank Building, Wichita, Kansas

STATE OF Kansas, COUNTY OF Sedgwick

E. K. Edmiston

(owner or operator) of the above-described well, being first duly sworn on oath, says: That I have knowledge of the facts, statements, and matters herein contained and the log of the above-described well as filed and that the same are true and correct. So help me God.

(Signature)


E. K. Edmiston  
First National Bank Building, Wichita, Ks.  
(Address)

SUBSCRIBED AND SWORN to before me this 8th day of August, 1966

My commission expires August 25, 1968

A. B. Barger  
A. B. Barger

Notary Public.

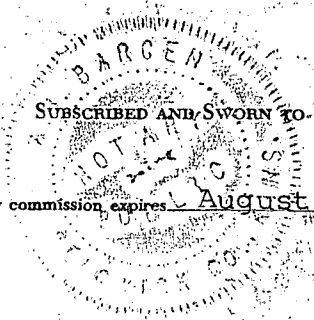

DRILLER'S LOG

Company: E. K. Edmiston  
 First National Bank Building  
 Wichita, Kansas 67202

Rotary Drilling Commenced: July 25, 1966

Rotary Drilling Completed: August 4, 1966

Well Name: MASSONI No. 1  
 c SE NE 24-30S-11W  
 Barber County, Kansas

Contractor: E. K. Edmiston Drilling Co., Inc.  
 First National Bank Building  
 Wichita, Kansas 67202

Casing Record: 255' of 8-5/8" w/175 sacks cement

L O G

Measurements from top of Kelly bushing

Sand and Shale	0 - 255
Red Bed and Shale	643
Shale and Shells	1390
Shale and Lime	1595
Lime and Shale	3965
Lime	4766
Sand	4770
Lime	4800 RTD

RECEIVED  
STATE CORPORATION COMMISSION

AUG 10 1966

CONSERVATION DIVISION  
Wichita, Kansas

The undersigned, E. K. Edmiston, President of E. K. Edmiston Drilling Co., Inc., hereby certifies on behalf of said company, that the above log is a true and correct log of the formations encountered in drilling the above well, as reflected by the daily drilling reports.

E. K. EDMISTON DRILLING CO., INC.

By *E. K. Edmiston*  
E. K. Edmiston, President

STATE OF KANSAS,  
SS:  
SEDGWICK COUNTY,

BE IT REMEMBERED that on this 8th day of August, 1966, before me, the undersigned, a Notary Public within and for the county and state aforesaid, came E. K. Edmiston, known to me to be the same person who executed the foregoing instrument as President and on behalf of the E. K. Edmiston Drilling Co., Inc., and he duly acknowledged the execution of the same for himself and for said company.

IN WITNESS WHEREOF, I have hereunto set my hand and official seal on the day and year last above written.

*A. B. Bargaen*  
A. B. Bargaen Notary Public

