


STATE OF KANSAS
STATE CORPORATION COMMISSION

Form CP-4

Give All Information Completely
Make Required Affidavit
Mail or Deliver Report to:
Conservation Division
State Corporation Commission
212 No. Market
Wichita, Kansas 67202

WELL PLUGGING RECORD

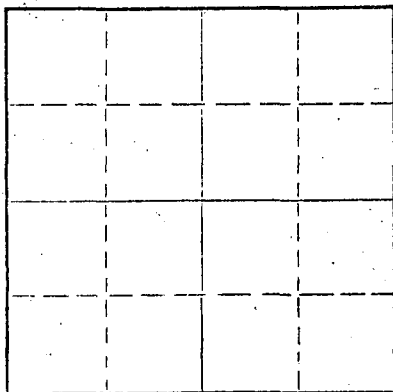

Locate well correctly on above
Section Plat

Barber County, Sec. 22 Twp. 30 Rge. (E) 11 (W)
Location as "NE/CNWxSWx" or footage from lines C SE/4 NE/4
Lease Owner Wyant & O'Keefe
Lease Name Douthett Well No. 1
Office Address 222 N. E. 50th, Okla. City, Okla.
Character of Well (completed as Oil, Gas or Dry Hole) Dry Hole
Date well completed September 2 19 70
Application for plugging filed September 2 19 70
Application for plugging approved September 2 19 70
Plugging commenced September 2 19 70
Plugging completed September 2 19 70
Reason for abandonment of well or producing formation Dry

If a producing well is abandoned, date of last production 19
Was permission obtained from the Conservation Division or its agents before plugging was commenced? Yes

Name of Conservation Agent who supervised plugging of this well G. R. Biberstein
Producing formation Depth to top Bottom Total Depth of Well 4847 Feet
Show depth and thickness of all water, oil and gas formations.

OIL, GAS OR WATER RECORDS

CASING RECORD

FORMATION	CONTENT	FROM	TO	SIZE	PUT IN	PULLED OUT
				8 5/8	285'	

Describe in detail the manner in which the well was plugged, indicating where the mud fluid was placed and the method or methods used in introducing it into the hole. If cement or other plugs were used, state the character of same and depth placed, from feet to feet for each plug set.

Bottom plug @ 250' w/25 sx.
Top plug @ 40' w/10 sx.

RECEIVED
STATE CORPORATION COMMISSION
SEP 8 1970
CONSERVATION DIVISION
Wichita, Kansas

(If additional description is necessary, use BACK of this sheet)
Name of Plugging Contractor Woodman & Iannitti Drilling Company
Address 706 Union National Bldg.

STATE OF KANSAS, COUNTY OF SEDGWICK, ss.
K. T. WOODMAN (employee of owner) or (owner or operator) of the above-described well, being first duly sworn on oath, says: That I have knowledge of the facts, statements, and matters herein contained and the log of the above-described well as filed and that the same are true and correct. So help me God.

(Signature) K. T. Woodman
706 Union Nat'l. Bldg.
(Address)

SUBSCRIBED AND SWORN TO before me this 4th day of September, 19 70

My commission expires Feb. 11, 1972
Justina Chamberlain
Justina Chamberlain Notary Public.

WOODMAN & IANNITTI DRILLING COMPANY
706 Union National Building
Wichita, Kansas 67202

September 4, 1970

Company; Wyant & O'Keeffe
Farm; Douthett #1
Location; C SE/4 NE/4
Section; 22-30-11W
County; Barber
Total Depth; 4847'
Comm; August 20, 1970
Compl; September 2, 1970
Casing; 8 5/8" @ 285' w/200 sx
Production; D & A

Figures Indicate Bottom of Formations

20	Clay
210	Sand & Clay
286	Red Shale
350	Red Shale
1035	Red Bed & Lime
1670	Shale & Shells
1710	Shale & Lime
1830	Lime & Shale
2025	Lime
2176	Lime
2310	Lime
2450	Lime
2571	Lime
2765	Lime & Shale
3005	Lime & Shale
3146	Lime & Shale
3275	Lime & Shale
3515	Shale & Lime
3672	Shale & Lime
3740	Lime & Shale
3895	Lime & Shale
3944	Lime
3982	Lime
4056	Lime
4124	Lime
4168	Lime
4239	Lime
4298	Lime
4348	Lime
4400	Lime
4450	Lime (Miss)
4468	Shale
4532	Lime
4591	Lime & Shale
4627	Lime & Shale
4684	Lime
4735	Dolomite
4783	Lime
4803	Lime
4832	Lime
4847	Lime (T.D.)

RECEIVED
STATE CORPORATION COMMISSION
SEP 8 1970
CONSERVATION DIVISION
Wichita, Kansas

I certify the above to be a true and correct copy of the driller's log and the geological tops to the best of my knowledge and belief.

Woodman & Iannitti Drilling Co.

K. T. Woodman
K. T. Woodman