

STATE OF KANSAS  
STATE CORPORATION COMMISSION

WELL PLUGGING RECORD

Give All Information Completely  
Make Required Affidavit  
Mail or Deliver Report to  
Conservation Division  
State Corporation Comm.  
245 North Water  
Wichita, KS 67202

BARBER County, Sec. 11 Twp. 34S Rge. 13W E/W  
Location as "NE/CNW1SW1" or footage from lines  
150' N of NE SW


Lease Owner PICKRELL DRILLING COMPANY  
Lease Name DONOVAN "B" Well No. 1  
Office Address 205 LITWIN BLDG., WICHITA, KS. 67530  
Character of Well (Completed as Oil, Gas or Dry Hole)  
Dry Hole

Date Well completed 8-24-79 19  
Application for plugging filed 8-24-79 19  
Application for plugging approved 8-24-79 19  
Plugging commenced 8-24-79 19  
Plugging completed 8-24-79 19  
Reason for abandonment of well or producing formation  
Dry Hole

If a producing well is abandoned, date of last production  
19

Was permission obtained from the Conservation Division or  
its agents before plugging was commenced? Yes

Name of Conservation Agent who supervised plugging of this well Wm. T. Owens  
Producing formation Depth to top Bottom Total Depth of Well 5200  
Show depth and thickness of all water, oil and gas formations.

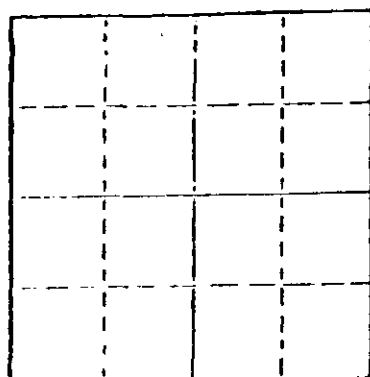

Locate well correctly on above  
Section Plot

OIL, GAS OR WATER RECORDS

CASING RECORD

FORMATION	CONTENT	FROM	TO	SIZE	PUT IN	PULLED OUT
				8 5/8"	263	None

Describe in detail the manner in which the well was plugged, indicating where the mud fluid was placed and the method or methods used in introducing it into the hold. If cement or other plugs were used, state the character of same and depth placed, from feet to feet for each plug set.

40 sacks at 240'  
12 sacks at 40'  
3 sacks in rathole Comp. 8:00AM 9-7-79

RECEIVED  
STATE CORPORATION COMMISSION

SEP 17 1979

(If additional description is necessary, use BACK of this report)  
Name of Plugging Contractor PICKRELL DRILLING COMPANY

STATE OF Kansas COUNTY OF Sedgwick, ss.  
C. W. Sebitts (employee of owner) or (owner or operator)  
of the above-described well, being first duly sworn on oath, says: That I have knowledge of the facts, statements, and matters herein contained and the log of the above-described well as filed and that the same are true and correct. So help me God. By: C. W. Sebitts

(Signature) *C. W. Sebitts*  
205 LITWIN BLDG., WICHITA, KS. 67530  
(Address)

SUBSCRIBED AND SWORN TO before me this 12 day of September, 19 79

My commission expires 2-18-80

*Jo Ann Sarver*  
Notary Public.  
Jo Ann Sarver



**ROTARY DRILLING LOG**

COMPANY: PICKRELL DRILLING COMPANY  
 205 LITWIN BLDG.,  
 WICHITA, KS. 67202  
 LOCATION: DONOVAN "B" #1  
 150' N of NE SW Sec. 11-34S-13W  
 Barber County, Kansas  
 CONTRACTOR: **PICKRELL DRILLING COMPANY**  
**Wichita, Kansas**

Rotary Drilling Commenced 8-23-79

Rotary Drilling Completed 9-07-79

CASING RECORD: Surf. csg. 8 5/8" set at 263' w/200sx. Comp. 8-24-79 @ 6:45PM

**LOG**

(Figures indicate bottom of formation — measurements from top of rotary bushing.)

Top Soil	70	Lime & Shale	5140
Top Soil & Bed Beds	115	Lime	5170
Red Rock	263	Lime	5180
Red Bed	830	Lime	5200
Shale	1650		
Shale	1765		
Lime & Shale	1905		
Lime & Shale	2070		
Lime & Shale	2280		
Lime & Shale	2455		
Shale & Lime	2615		
Lime & Shale	2795		
Lime & Shale	2995		
Lime & Shale	3150		
Lime & Shale	3265		
Lime & Shale	3475		
Lime & Shale	3525		
Lime & Shale	3730		
Lime & Shale	3865		
Lime & Shale	4020		
Lime & Shale	4150		
Lime & Shale	4245		
Lime	4355		
Lime & Shale	4470		
Lime & Shale	4575		
Lime	4650		
Lime	4715		
Lime	4740		
Lime	4800		
Shale	4805		
Lime & Shale	4865		
Lime	4920		
Lime	4950		
Lime & Shale	5030		
Shale & Lime	5060		
Lime	5065		

STATE RECEIVED  
 STATE HISTORICAL COMMISSION  
**SEP 17 1979**  
 CONSERVATION DIVISION  
 Wichita, Kansas

The undersigned, C. W. Sebitts, Attorney-in-Fact for PICKRELL DRILLING COMPANY, hereby certifies in behalf of said Company, that the above is a true and correct log of the formation encountered in drilling the above well as reflected by the Daily Drilling Reports.

PICKRELL DRILLING COMPANY  
 By *C. W. Sebitts*  
 Attorney-in-Fact  
 C. W. Sebitts

STATE OF KANSAS }  
 COUNTY OF SEDGWICK } ss.:

On this 12 day of September, 1979, before me the undersigned, a Notary Public, in and for the County and State aforesaid, personally appeared C. W. Sebitts, to me known to be the identical person who subscribed the name of PICKRELL DRILLING COMPANY to the foregoing instrument as its Attorney-in-Fact and acknowledged to me that he executed the same as his free and voluntary act and deed, and as the free and voluntary act and deed of such company, for the uses and purposes therein set forth.

Given under my hand and seal of office the day and year last above written.

My commission expires: \_\_\_\_\_

*Jo Ann Sarver*  
 Notary Public  
 Jo Ann Sarver

