

STATE OF KANSAS
STATE CORPORATION COMMISSION

WELL PLUGGING RECORD


Give All Information Completely
Make Required Affidavit
Mail or Deliver Report to:
Conservation Division
State Corporation Commission
212 North Market, Insurance Bldg.
Wichita, Kansas

Barber

County, Sec. 11 Twp. 34 Rge. (E) 13 (W)

NORTH

Location as "NE/CNW&SW&" or footage from lines C SW SE
Lease Owner Aylward Drilling Company
Lease Name Donovan "D" Well No. 1
Office Address 909 First National Bank Bldg. - Wichita 2, Kansas
Character of Well (completed as Oil, Gas or Dry Hole) D & A
Date well completed May 28 1963
Application for plugging filed May 27 1963
Application for plugging approved May 28 1963
Plugging commenced May 28 1963
Plugging completed May 28 1963
Reason for abandonment of well or producing formation _____

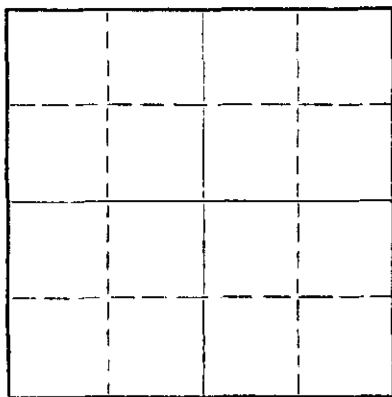

Locate well correctly on above
Section Plat

If a producing well is abandoned, date of last production _____ 19____
Was permission obtained from the Conservation Division or its agents before plugging was commenced? Yes

Name of Conservation Agent who supervised plugging of this well Archie Elving
Producing formation None Depth to top _____ Bottom _____ Total Depth of Well 5308 Feet
Show depth and thickness of all water, oil and gas formations.

OIL, GAS OR WATER RECORDS

CASING RECORD

FORMATION	CONTENT	FROM	TO	SIZE	PUT IN	PULLED OUT
				8 5/8"	251'	None

Describe in detail the manner in which the well was plugged, indicating where the mud fluid was placed and the method or methods used in introducing it into the hole. If cement or other plugs were used, state the character of same and depth placed, from _____ feet to _____ feet for each plug set.

Filled with heavy mud to 180'
Set plug and 20 sacks of cement at 180'
Heavy mud to 40'. Set plug and 10 sacks cement at 40'
Bridged rat hole and plugged with 2 sacks cement.

RECEIVED
STATE CORPORATION COMMISSION

JUN 27 1963

CONSERVATION DIVISION
Wichita, Kansas

(If additional description is necessary, use BACK of this sheet)

Name of Plugging Contractor Company tools
Address _____

STATE OF KANSAS, COUNTY OF SEDGWICK, ss.
Charles D. Williams (employee of owner) ~~or operator~~ of the above-described well, being first duly sworn on oath, says: That I have knowledge of the facts, statements, and matters herein contained and the log of the above-described well as filed and that the same are true and correct. So help me God.

(Signature) Charles D. Williams
909 1st Nat'l Bank Bldg., Wichita 2, Kansas
(Address)

SUBSCRIBED AND SWORN TO before me this 14th day of June, 1963

My commission expires December 11, 1965

Duane Jessup
DUANE JESSUP Notary Public.

DONOVAN "D" #1

Casing Record:
8 5/8" - 251'

Company: Aylward Drilling Company
Contractor: Aylward Drilling Company

Location: C SW SE 8
Sec. 11-34-13W
Barber County
Kansas

Commenced: May 10, 1963
Completed: May 28, 1963

Elevation: 1584 K.B.

	<u>From</u>	<u>To</u>	<u>Remarks</u>	
Sand & Red Bed	0	100	Set 8 5/8" surface pipe @ 251' w/250 sacks cement.	
Red Bed	100	2250		
Shale & Shells	250	1465	Geological Tops:	
Shale & Lime	1465	1855		
Shale & Shells	1855	2045		
Lime & Shale	2045	2475		Elgin Zone 3648
Lime & Shale Streaks	2475	2620		Elgin Sandstone 3758
Lime & Shale	2620	4020		Heebner 3861
Lime	4020	4540		Douglas 3883
Lime & Shale	4540	4750		Lansing-Kansas City 4058
Lime	4750	4990		Base Kansas City 4553
Lime & Shale	4990	5052		Mississippi 4692
Lime	5052	5150		Kinderhook 4918
Lime & Shale	5150	5190		Chattanooga 4980
Lime & Sand	5190	5195		Viola 5032
Lime	5195	5308 T.D.		Simpson Shale 5135
				Simpson Sandstone 5146
				Lower Simpson Sand 5268

DST 4791-4836 Open 70"
Rec. 250' wtry mud, 240' wtr.
IBHP 2096#/30" - FBHP 1973#/30"
FP 52#-250#

D & A

I hereby certify that this is a true and correct copy of the above log to the best of my knowledge.

Charles W. Williams

Subscribed and sworn to before me this 12th day of June, 1963

Duane Jessup
DUANE JESSUP Notary Public

My commission expires December 11, 1965

RECEIVED
STATE CORPORATION COMMISSION

JUN 27 1963

CONSERVATION DIVISION
Wichita, Kansas