


STATE OF KANSAS  
STATE CORPORATION COMMISSION

WELL PLUGGING RECORD

Give All Information Completely  
Make Required Affidavit  
Mail or Deliver Report to  
Conservation Division  
State Corporation Comm.  
245 North Water  
Wichita, KS 67202

Barber County, Sec. 17 Twp. 34-S Rge. 13 ~~XX~~W  
Location as "NE/CNW $\frac{1}{4}$ SW $\frac{1}{4}$ " or footage from lines  
C/SE/4/NE/4  
Lease Owner Petroleum Technical Services Company  
Lease Name David Diel Well No. 1  
Office Address 3000 N. Garfield, #210, Midland, Texas 79701  
Character of Well (Completed as Oil, Gas or Dry Hole)  
Dry  
Date Well completed 11-6- 1981  
Application for plugging filed (Verbal) 3-17- 1982  
Application for plugging approved (Verbal) 3-17- 1982  
Plugging commenced 3-18- 1982  
Plugging completed 3-18- 1982  
Reason for abandonment of well or producing formation  
Dry hole.  
If a producing well is abandoned, date of last production  
N/A 19  
Was permission obtained from the Conservation Division or  
its agents before plugging was commenced? Yes. (Verbal)

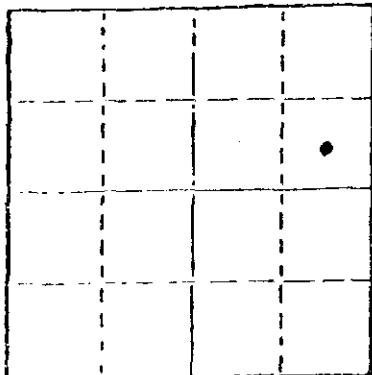

Locate well correctly on above  
Section Plat

Name of Conservation Agent who supervised plugging of this well Maurice Leslie  
Producing formation None Depth to top Bottom Total Depth of Well 4,909'  
Show depth and thickness of all water, oil and gas formations.

OIL, GAS OR WATER RECORDS

CASING RECORD

FORMATION	CONTENT	FROM	TO	SIZE	PUT IN	PULLED OUT
None				8-5/8"	596'	-0-
				4-1/2"	4,909'	2,315'

Describe in detail the manner in which the well was plugged, indicating where the mud fluid was placed and the method or methods used in introducing it into the hold. If cement or other plugs were used, state the character of same and depth placed, from \_\_\_\_\_ feet to \_\_\_\_\_ feet for each plug set.

- Set CIBP @4,670' w/20' cmt.
- Set CIBP @4,055' w/20' cmt. on plug.
- Spotted 50 sack cmt. plug @700' to 600'
- Spotted 25 sack cmt. plug @250' to 150'
- Spotted 10 sack cmt. plug @40' to surface.
- Spotted 5 sack cmt. plug @rat hole.

RECEIVED  
STATE CORPORATION COMMISSION  
APR - 5 1982 4-5-82

CONSERVATION DIVISION  
Wichita Kansas

(If additional description is necessary, use BACK of this sheet)

Name of Plugging Contractor Lloyd Jones Well Service Company (Permit #975), & Halliburton Services.

STATE OF Texas COUNTY OF Midland, ss.  
Don C. Bennett (employee of owner) or (owner, or operator)  
of the above-described well, being first duly sworn on oath, says: That I have knowledge of the facts, statements, and matters herein contained and the log of the above-described well as filed and that the same are true and correct. So help me God.

(Signature) Don C. Bennett  
3000 N. Garfield, #210, Midland, Texas 79701  
(Address)

SUBSCRIBED AND SWORN TO before me this 26th day of March, 1982

Nancy H. Lutz  
Notary Public.

My commission expires 3-14-84

STATE CORPORATION COMMISSION  
 CONSERVATION DIVISION  
 200 Colorado, Derby Bldg.  
 Wichita, Kansas 67202-1286

## INVOICE and WELL PLUGGING AUTHORITY

March 26, 1982

INVOICE NUMBER: 9782-W

TO: Petroleum Technical Service  
3000 N. Garfield Suite 210  
Midland Texas 79701

## PLUGGING ASSESSMENT AS FOLLOWS:

Diel #1  
 1850' FNL & 685' FEL Sec. 17-34-13W  
 Barber  
 4910' \$159.58

NOTE: We also need the following before our file is completed:

- X  Well Plugging Record (CP-4)  
 X  Well Log  
 X  Well Plugging Application (CP-1)

## WELL PLUGGING AUTHORITY

Gentlemen:

This is your authority to plug the above subject well in accordance with the rules and regulations of the state corporation commission.

This authority is void after ninety (90) days from the above date.

  
 \_\_\_\_\_  
 Administrator

Mr. Maurice Leslie R.R. 1 Nashville Kansas 67112 (316)246-5303

is hereby assigned to supervise the plugging of the above mentioned well.