

WELL PLUGGING RECORD

Give All Information Completely
Make Required Affidavit
Mail or Deliver Report to:
Conservation Division
State Corporation Commission
211 No. Broadway
Wichita, Kansas

BARBER County.


Sec. 22

Twp. 31S

Rge. 10W (E)

(W)

NORTH

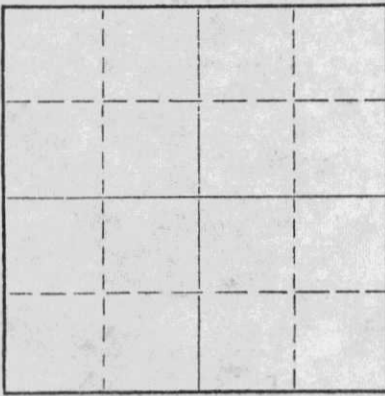

Locate well correctly on above
Section Plat

Location as "NE/CNW%SW%" or footage from lines C NW NE

Lease Owner Solar Oil Company

Lease Name GEORGE STONE Well No. 1

Office Address 1117 Union Nat'l. Bldg., Wichita, Kansas 67202

Character of Well (completed as Oil, Gas or Dry Hole) DRY HOLE

Date well completed June 4, 1964

Application for plugging filed June 3/4, 1964

Application for plugging approved June 3/4, 1964

Plugging commenced June 3/4, 1964

Plugging completed June 3/4, 1964

Reason for abandonment of well or producing formation DRY HOLE

If a producing well is abandoned, date of last production _____ 19____

Was permission obtained from the Conservation Division or its agents before plugging was commenced? YES

Name of Conservation Agent who supervised plugging of this well Herman E. Justus, Nickerson, Kansas

Producing formation _____ Depth to top _____ Bottom _____ Total Depth of Well 4965 Feet

Show depth and thickness of all water, oil and gas formations.

OIL, GAS OR WATER RECORDS

CASING RECORD

FORMATION	CONTENT	FROM	TO	SIZE	PUT IN	PULLED OUT
<u>Sand, Shale & Red Bed</u>	<u>Surface Casing</u>	<u>0-</u>	<u>250'</u>	<u>8-5/8"</u>	<u>250'</u>	<u>None</u>

Describe in detail the manner in which the well was plugged, indicating where the mud fluid was placed and the method or methods used in introducing it into the hole. If cement or other plugs were used, state the character of same and depth placed, from _____ feet to _____ feet for each plug set.

PLUGGED: Filled hole with mud from 4965' to 260', plug, bridge & 25 sx. cement. Filled with mud up to 40', plug, bridge & 10 sx. cement. Job completed 8 p.m., 6-3-64.

RECEIVED
STATE CORPORATION COMMISSION
6-8-64
JUN 8 1964

CONSERVATION DIVISION
Wichita, Kansas

(If additional description is necessary, use BACK of this sheet)
Name of Plugging Contractor SIERRA PETROLEUM CO., INC.
Address 1015 Wichita Plaza Bldg., Wichita, Kansas 67202

STATE OF KANSAS, COUNTY OF RUSSELL, ss.
S. P. Hall, Superintendent (employee of owner) or (owner or operator) of the above-described well, being first duly sworn on oath, says: That I have knowledge of the facts, statements, and matters herein contained and the log of the above-described well as filed and that the same are true and correct. So help me God. S. P. Hall
(Signature) S. P. Hall, Superintendent
Box 232, Russell, Kansas 67665
(Address)

SUBSCRIBED AND SWORN TO before me this 5th day of June, 1964

My commission expires 10-17-67

Gray Dutz
Notary Public.

SOLAR OIL COMPANY - Operator

SIERRA PETROLEUM CO., INC. - Contractor

GEORGE STONE #1
C NW NE
Sec. 22-31S-10W
Barber County, Kansas

T. D.: 4965'
Elev.: 1681' K.B.

Commenced: 5-19-64
Completed: 6-4-64

Casing:

8-5/8" Set at 250'

Cement:

with 200 sx. Common

FORMATION

DEPTH

Sand	50
Shale	135
Red Bed	505
Red Bed & Shale	1265
Shale, Shells & Salt	1700
Lime & Shale	3470
Shale, Sand & Lime	3615
Shale & Lime	3795
Lime	4380
Lime & Shale	4460
Lime & Chert	4472
Mississippi Chat	4482
Lime & Chert	4525
Lime	4555
Lime & Chert	4640
Lime	4790
Simpson	4946
Arbuckle	4965

RECEIVED
STATE CORPORATION COMMISSION

JUN 8 1964
6-8-64
CONSERVATION DIVISION
Wichita, Kansas

STATE OF KANSAS)
) ss:
COUNTY OF RUSSELL)

I hereby certify that the above information is true and correct to the best of my knowledge.

S. P. Hall
Superintendent

Subscribed and sworn to before me this 5th day of June, 1964.

Lesoy Ditz
Notary Public

My commission expires: 10-17-67