


STATE OF KANSAS
STATE CORPORATION COMMISSION
CONSERVATION DIVISION
P. O. BOX 17027
WICHITA, KANSAS 67217

FORM CP-4

WELL PLUGGING RECORD

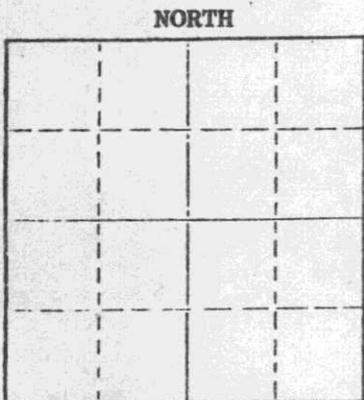

Locate well correctly on above Section Plat

Barber County. Sec. 23 Twp. 31S Rge. 10W (E) (W)
Location as "NE/CNW/SE" or footage from lines C NW SE
Lease Owner Sidwell Oil & Gas, Inc.
Lease Name Best Estate Well No. 1
Office Address P. O. Box 2475, Pampa, Texas 79065
Character of Well (completed as Oil, Gas or Dry Hole) Dry Hole
Date well completed 2-8 19 75
Application for plugging filed 2-8 19 75
Application for plugging approved 2-8 19 75
Plugging commenced 2-8 19 75
Plugging completed 2-8 19 75
Reason for abandonment of well or producing formation

If a producing well is abandoned, date of last production 19
Was permission obtained from the Conservation Division or its agents before plugging was commenced? Yes

Name of Conservation Agent who supervised plugging of this well Russell Biberstein
Producing formation Depth to top Bottom Total Depth of Well 4645 F-1
Show depth and thickness of all water, oil and gas formations.

OIL, GAS OR WATER RECORDS

CASING RECORD

FORMATION	CONTENT	FROM	TO	SIZE	PUT IN	PULLED OUT
				8-5/8"	318'	-

Describe in detail the manner in which the well was plugged, indicating where the mud fluid was placed and the method or methods used in introducing it into the hole. If cement or other plugs were used, state the character of same and depth placed, from feet to feet for each plug set.

Mud to 250', 35 sacks cement
Mud to 40', plug, 1/4 sack hulls, 10 sacks cement
2 sacks cement in rathole

(If additional description is necessary, use BACK of this sheet)

Name of Plugging Contractor
Address

STATE OF KANSAS COUNTY OF SEDGWICK, ss.
Don Gardner (employee of owner) or (owner or operator) of the above-described

well, being first duly sworn on oath, says: That I have knowledge of the facts, statements, and matters herein contained and the log of the above-described well as filed and that the same are true and correct. So help me God.

(Signature) [Signature]
Suite 250, 200 W. Douglas, Wichita, Kansas
(Address)

SUBSCRIBED AND SWORN TO before me this 10th day of February, 19 75

My commission expires December 14, 1977

[Signature] Notary Public.

RECEIVED
STATE CORPORATION COMMISSION
FEB 11 1975
CONSERVATION DIVISION
Wichita, Kansas

DRILLERS LOG

#1 BEST ESTATE
C NW SE Section 23-31S-10W
Barber County, Kansas

OPERATOR: Sidwell Oil & Gas, Inc.
P. O. Box 2475
Pampa, Texas 79065

CONTRACTOR: Dunne-Gardner Petroleum, Inc.
Suite 250, 200 West Douglas
Wichita, Kansas 67202

COMMENCED: January 25, 1975


COMPLETED: February 8, 1975

CASING RECORD: 8-5/8" @ 318' w/250 sx

<u>FROM</u>	<u>TO</u>	<u>DESCRIPTION</u>
0	160	Clay and sand
160	495	Shale
495	1190	Shale and red bed
1190	3815	Lime and shale
3815	4540	Lime
4540	4645	Cherty lime
4645		Rotary total depth

STATE OF KANSAS)
) ss
COUNTY OF SEDGWICK)


I hereby certify that the above is a true and correct log, to the best of my knowledge and belief.

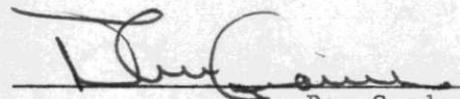

Don Gardner

Subscribed and sworn to before me this 10th day of February, 1975.

My commission expires:
December 14, 1977

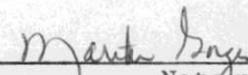

Notary Public

RECEIVED
STATE CORPORATION COMMISSION

FEB 11 1975

CONSERVATION DIVISION
Wichita, Kansas