


Give All Information Completely
Make Required Affidavit
Mail or Deliver Report to:
Conservation Division
State Corporation Commission
212 No. Market
Wichita, Kansas

WELL PLUGGING RECORD

NORTH

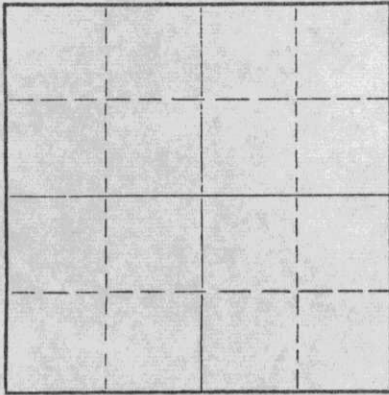

Locate well correctly on above
Section Plat

Barber County, Sec. 7 Twp. 31S Rge. 10W(E) (W)

Location as "NE/CNW/SW" or footage from lines c NL NW SW

Lease Owner E. K. Edmiston

Lease Name WARWICK-ALLENDER "B" Well No. -1-

Office Address First National Bank Building, Wichita, Kansas

Character of Well (completed as Oil, Gas or Dry Hole) dry hole

Date well completed June 18, 1966 19

Application for plugging filed June 18, 1966 19

Application for plugging approved June 18, 1966 19

Plugging commenced June 18, 1966 19

Plugging completed June 18, 1966 19

Reason for abandonment of well or producing formation dry hole

If a producing well is abandoned, date of last production 19

Was permission obtained from the Conservation Division or its agents before plugging was commenced? yes

Name of Conservation Agent who supervised plugging of this well Archie Elving

Producing formation --- Depth to top --- Bottom --- Total Depth of Well 4597' Feet

Show depth and thickness of all water, oil and gas formations.

OIL, GAS OR WATER RECORDS

CASING RECORD

FORMATION	CONTENT	FROM	TO	SIZE	PUT IN	PULLED OUT
				8-5/8"	230'	---

Describe in detail the manner in which the well was plugged, indicating where the mud fluid was placed and the method or methods used in introducing it into the hole. If cement or other plugs were used, state the character of same and depth placed, from --- feet to --- feet for each plug set.

plug hole 7:30 to 10:00, mix cement through drill pipe, plug hole as follows, heavy mud to 225', 1/2 sack hulls, plug 25 sacks cement, heavy mud to 40', 1/2 sack hulls, bridge and 10 sacks cement.

RECEIVED
STATE CORPORATION COMMISSION
7-1-66
JUL 1 1966
CONSERVATION DIVISION
Wichita, Kansas

(If additional description is necessary, use BACK of this sheet)

Name of Plugging Contractor E. K. Edmiston Drilling Co., Inc.

Address First National Bank Building, Wichita, Kansas

STATE OF KANSAS, COUNTY OF SEDGWICK, ss.

E. K. Edmiston, owner, of the above-described well, being first duly sworn on oath, says: That I have knowledge of the facts, statements, and matters herein contained and the log of the above-described well as filed and that the same are true and correct. So help me God.

(Signature) E. K. Edmiston
First National Bank Building, Wichita, Ks.
(Address)

SUBSCRIBED AND SWORN TO before me this 30th day of June, 1966

A. B. Barger
Notary Public.

My commission expires August 25, 1968

DRILLER'S LOG

Company: E. K. Edmiston
 First National Bank Building
 Wichita, Kansas 67202

Rotary Drilling Commenced: June 8, 1966

Rotary Drilling Completed: June 18, 1966

Well Name: WARWICK-ALLENDER "B" No. 1
 c NL NW SW 7-31S-10W
 Barber County, Kansas

Contractor: E. K. Edmiston Drilling Co., Inc.
 First National Bank Building
 Wichita, Kansas 67202

Casing Record: 8-5/8" to 230' with 200 sacks cement

L O G

Measurements from top of Kelly bushing

Sand	0 - 160
Lime	230
Red Bed and Shale	790
Shale	1690
Shale and Lime	1900
Lime	2325
Lime and Shale	2810
Shale and Lime	2980
Lime and Shale	3251
Shale and Lime	3435
Lime and Shale	4020
Lime	4597 RTD

RECEIVED
 STATE CORPORATION COMMISSION
 JUL 1 1966
 CONSERVATION DIVISION
 Wichita, Kansas

The undersigned, E. K. Edmiston, President of E. K. Edmiston Drilling Co., Inc., hereby certifies on behalf of said company that the above log is a true and correct log of the formations encountered in the drilling of the above well, as reflected by the daily drilling reports.

E. K. EDMISTON DRILLING CO., INC.

By E. K. Edmiston
 E. K. Edmiston, President

STATE OF KANSAS,
 SS:
 SEDGWICK COUNTY,

BE IT REMEMBERED that on this 30th day of June, 1966, before me, the undersigned, a Notary Public in and for the county and state aforesaid, came E. K. EDMISTON, known to me to be the same person who executed the foregoing instrument as President and on behalf of the E. K. Edmiston Drilling Co., Inc., and he duly acknowledged the execution of the same for himself and for said company.

IN WITNESS WHEREOF, I have hereunto set my hand and official seal on the day and year last above written.

A. B. Barga
 A. B. Barga, Notary Public

My commission expires
 August 25, 1968

