


Give All Information Completely  
Make Required Affidavit  
Mail or Deliver Report to:  
Conservation Division  
State Corporation Commission  
211 No. Broadway  
Wichita, Kansas

WELL PLUGGING RECORD

NORTH

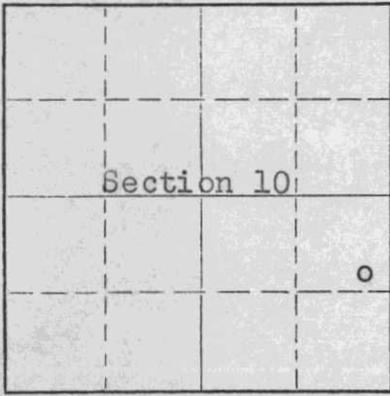

Locate well correctly on above  
Section Plat

Barber County. Sec. 10 Twp. 31 Rge. 10 (E) W (W)  
Location as "NE/CNW/SW" or footage from lines SE NE SE  
Lease Owner Petroleum, Inc.  
Lease Name Adams "C" Well No. 1  
Office Address Route 2, Great Bend, Kansas  
Character of Well (completed as Oil, Gas or Dry Hole) Dry hole  
Date well completed May 11 19 57  
Application for plugging filed May 11 19 57  
Application for plugging approved May 11 19 57  
Plugging commenced May 11 19 57  
Plugging completed May 11 19 57  
Reason for abandonment of well or producing formation No Produccible zones

If a producing well is abandoned, date of last production None 19       
Was permission obtained from the Conservation Division or its agents before plugging was commenced? Yes

Name of Conservation Agent who supervised plugging of this well M.A. Rives Pratt, Kansas  
Producing formation --- Depth to top --- Bottom --- Total Depth of Well 4536 Feet  
Show depth and thickness of all water, oil and gas formations.

OIL, GAS OR WATER RECORDS

CASING RECORD

FORMATION	CONTENT	FROM	TO	SIZE	PUT IN	PULLED OUT
				8 5/8"	247'	None

Describe in detail the manner in which the well was plugged, indicating where the mud fluid was placed and the method or methods used in introducing it into the hole. If cement or other plugs were used, state the character of same and depth placed, from      feet to      feet for each plug set.

Mud up with heavy mud to 240', pushed down 1/4 sack hulls to 240' followed by wooden plug. Placed 20 sacks cement through drill pipe on to plug. Mud up to 35' and placed 1/4 sack hulls at 35' followed by wooden plug and 10 sacks cement to base of well cellar.

RECEIVED  
STATE CORPORATION COMMISSION  
MAY 29 1957  
CONSERVATION DIVISION  
Wichita, Kansas

(If additional description is necessary, use BACK of this sheet)  
Name of Plugging Contractor Garvey Drilling Company  
Address Route 2, Great Bend, Kansas

STATE OF KANSAS, COUNTY OF BARTON, ss.  
Don Searle (employee of owner) or (~~owner or operator~~) of the above-described well, being first duly sworn on oath, says: That I have knowledge of the facts, statements, and matters herein contained and the log of the above-described well as filed and that the same are true and correct. So help me God.

(Signature) Don Searle  
Route 2, Great Bend, Kansas  
(Address)

SUBSCRIBED AND SWORN TO before me this 28th day of May, 19 57

My commission expires July 11, 1960  
Ed. A. Brown Notary Public.

PLUGGING  
FILE SEC 10 T 31 R 10W  
BOOK PAGE 12 LINE 25

# WELL LOG

COMPANY PETROLEUM, INCORPORATED

SEC. 10 T. 31S R. 10W

FARM ADAMS 'C' NO. 1

LOC. SE, NE, SE


TOTAL DEPTH 4536'

COUNTY Barber Co., Kansas

COMM. April 29, 1957

COMP. May 11, 1957

CONTRACTOR GARVEY DRILLING COMPANY

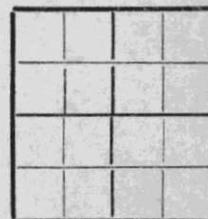

CASING 8 5/8" @ 247' W/175 sax.

ELEVATION 1728' DF

PRODUCTION D & A

FIGURES INDICATE BOTTOM OF FORMATIONS

1120	Sand & red bed
1765	Shale & shells
3677	Shale & lime
3835	Sand & shale
4267	Lime
4460	Lime & shale
4506	Shale, lime & chert
4514	Chert
4536	Lime
4536	T. D.

RECEIVED  
STATE CORPORATION COMMISSION  
MAY 29 1957  
CONSERVATION DIVISION  
Wichita, Kansas

PLUGGING  
FILE SEC 10 T 31 R 10W  
BOOK PAGE 12 LINE 25

State of KANSAS }  
County of BARTON } ss:

I, Verne A. Morris of Garvey Drilling Co.

upon oath state that the above and foregoing is a true and correct copy of the log of the #1 Adams 'C' well

Verne A. Morris

Subscribed and sworn to before me this 27th day of May 19 57

My Commission Expires: July 11, 1960

Leola Brown  
NOTARY PUBLIC