


Give All Information Completely
Make Required Affidavit
Mail or Deliver Report to:
Conservation Division
State Corporation Commission
211 No. Broadway
Wichita, Kansas

WELL PLUGGING RECORD

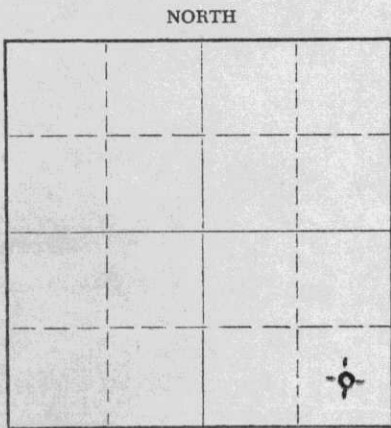

Locate well correctly on above Section Plat

Barber County. Sec. 18 Twp. 31S Rge. (E) 10 (W)
Location as "NE/CNW%SW%" or footage from lines C SE SE
Lease Owner Walters Drilling Co.
Lease Name Elliott 'C' Well No. 1
Office Address 510 Orpheum Building, Wichita, Kansas
Character of Well (completed as Oil, Gas or Dry Hole) Dry Hole
Date well completed April 4, 1960 19
Application for plugging filed April 6, 1960 19
Application for plugging approved Verbally approved by W. L. 19
Plugging commenced April 4, 1960 Lac Kamp 19
Plugging completed April 4, 1960 19
Reason for abandonment of well or producing formation _____

If a producing well is abandoned, date of last production _____ 19
Was permission obtained from the Conservation Division or its agents before plugging was commenced? Verbally approved by W. L. Lac Kamp on April 4, 1960

Name of Conservation Agent who supervised plugging of this well _____
Producing formation _____ Depth to top _____ Bottom _____ Total Depth of Well _____ Feet
Show depth and thickness of all water, oil and gas formations.

OIL, GAS OR WATER RECORDS

CASING RECORD

FORMATION	CONTENT	FROM	TD	SIZE	PUT IN	PULLED OUT
		Surface	218	8-5/8	213.87	

Describe in detail the manner in which the well was plugged, indicating where the mud fluid was placed and the method or methods used in introducing it into the hole. If cement or other plugs were used, state the character of same and depth placed, from _____ feet to _____ feet for each plug set.

Bottom plug @ 210' with hulls and 20 sacks cement thru drill pipe

RECEIVED
STATE CORPORATION COMMISSION
APR 7 1960
CONSERVATION DIVISION
Wichita, Kansas

(If additional description is necessary, use BACK of this sheet)
Name of Plugging Contractor Walters Drilling Co.
Address 510 Orpheum Building, Wichita, Kansas

STATE OF KANSAS, COUNTY OF SEDGWICK, ss.
Robert F. Walters (~~owner~~) or (owner or operator) of the above-described well, being first duly sworn on oath, says: That I have knowledge of the facts, statements, and matters herein contained and the log of the above-described well as filed and that the same are true and correct. So help me God.
(Signature) Robert F. Walters
510 Orpheum Building, Wichita, Kansas
(Address)

SUBSCRIBED AND SWORN TO before me this 6th day of April, 19 60

My commission expires January 4, 1964

R. L. Abel
Notary Public.



RECEIVED
STATE CONSERVATION COMMISSION

APR 7 1960

CONSERVATION DIVISION
Wichita, Kansas

ELLIOTT 'C' #1

Location: C SE SE Sec. 18-31S-10W
Barber County, Kansas

Operator: Walters Drilling Co.

Contractor: Walters Drilling Co.

Surface Casing: 8-5/8" set at 218'
w/175 sacks and 2% CC

Oil String: None

Date Spudded: 3/23/60

Date Completed: 4/4/60

Elevation: 1702 GR
1705 DF
1707 KB

L O G
(Figures indicate bottom of formation)

Surface	0 to 220
Red Bed	290
Shale & Red Bed	600
Shale & Shells	1020
Shale & Lime	3040
Shale, Lime & Sand	3200
Shale & Lime	3540
Shale, Lime & Sand	3655
Shale & Lime	3850
Lime	4160
Shale & Lime	4203
Lime	4308
Shale & Lime	4475
Sand	4490
Lime & Chert	4528
Total Depth	4528

The undersigned, Robert F. Walters, hereby certifies that the above log is a true and correct log of the formations encountered in drilling the above noted well as reflected by the Daily Drilling Reports.

WALTERS DRILLING CO.

BY

Robert F. Walters

Subscribed and sworn to before me
this 6th day of April, 1960

R. L. Abel

Notary Public

My commission expires:
January 4, 1964